


# T.30S.R.12W.W.M.

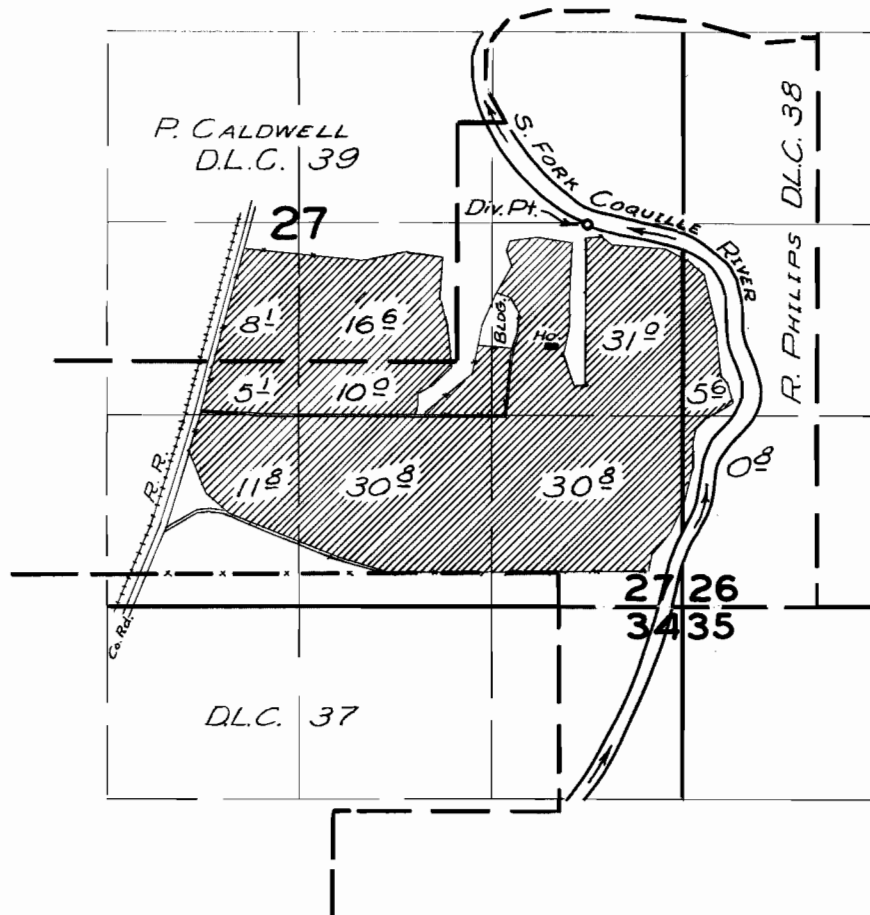

## FINAL PROOF SURVEY UNDER

Application No. 29359 Permit No. 23136  
IN NAME OF

ALBERT H. POWERS

Surveyed 8 JULY 1958, by M. Bish