


T.3S.R.24E.W.M.

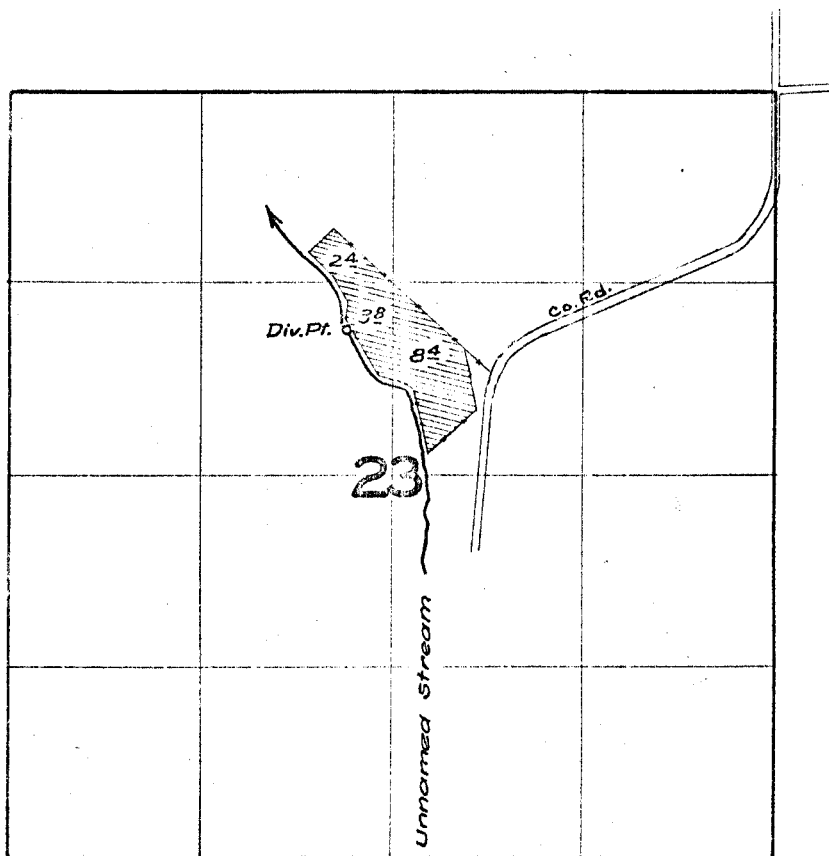

**FINAL PROOF SURVEY**  
UNDER

Application No. 29495 Permit No. 23273  
IN NAME OF

JOHN BERGSTROM

Surveyed 17 Oct. 1958, by M. Bish