


T. 12S. R. 4 & 5 W.W.M.

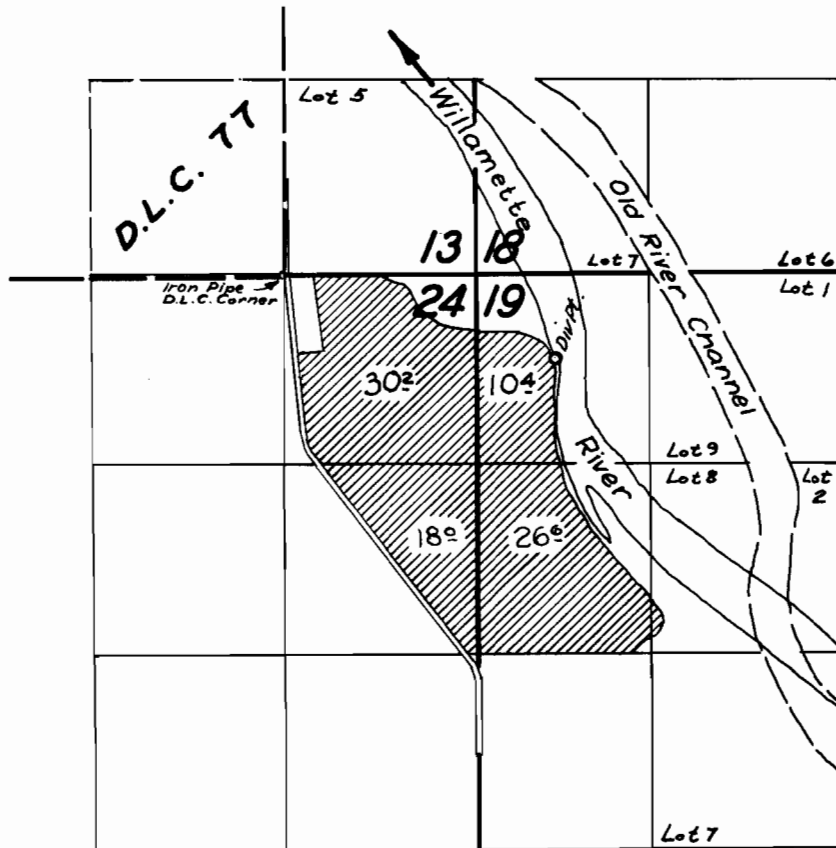

FINAL PROOF SURVEY
UNDER

Application No. 29984. Permit No. 23617.
IN NAME OF

C. E. JONES

Surveyed 23 Sept. 1958, by M. Bish
Rj