


T. 5S. R. 6W. W.M.

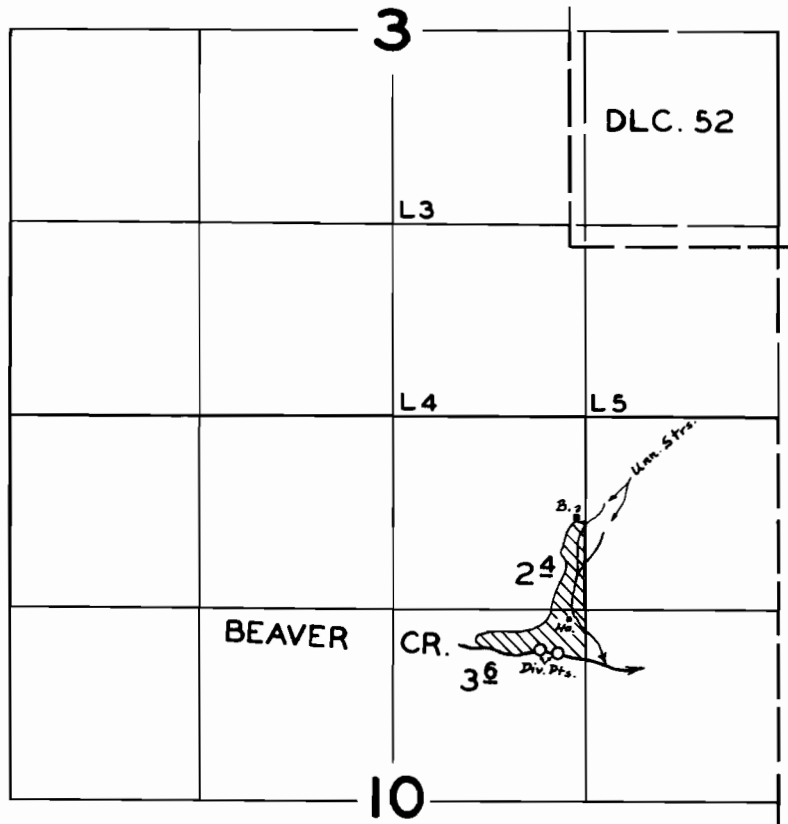

**FINAL PROOF SURVEY**  
UNDER

Application No. 30038. Permit No. 23647.  
IN NAME OF

**HAL E. WARNER**

Surveyed APR. 8 1958, by M. BISH