


T.12S. R.6 W.W.M.

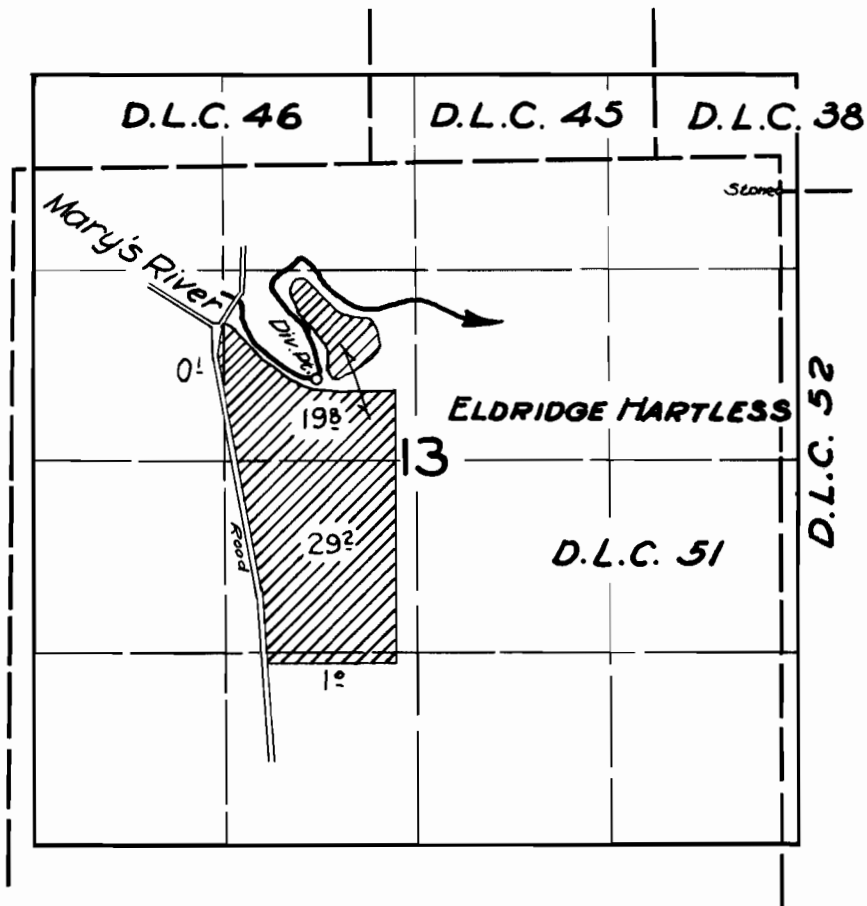

FINAL PROOF SURVEY
UNDER

Application No. 29850. Permit No. 23680.
IN NAME OF

ELMER J. BURNWORTH

Surveyed 26 Sept. 1958, by M. Bish
Ry