


T. 3S. R. 1E. W.M.

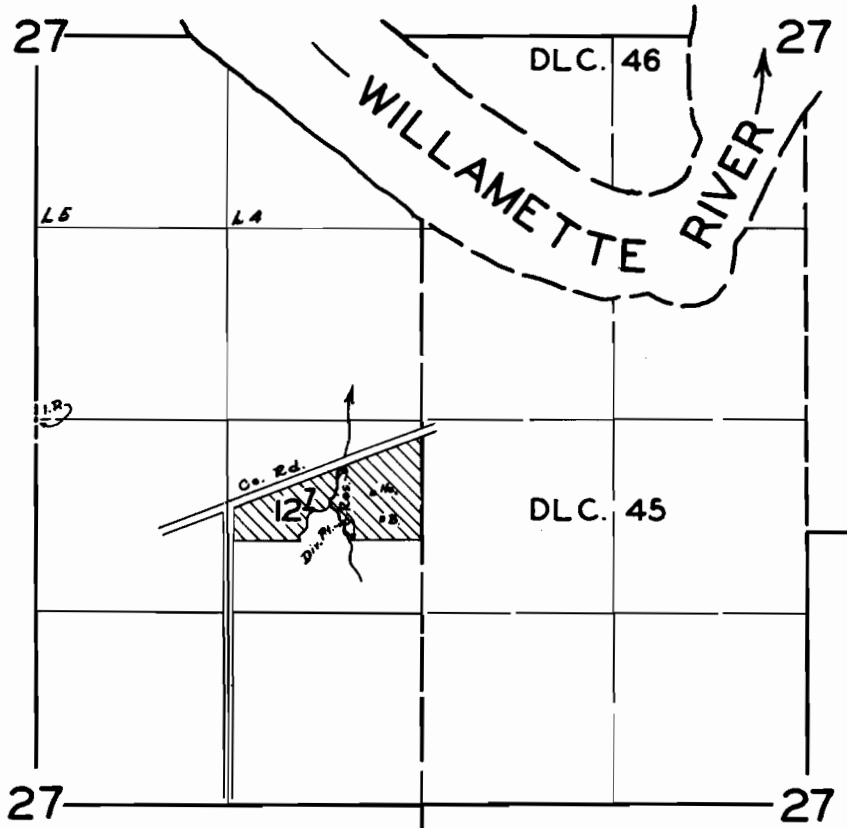

FINAL PROOF SURVEY
UNDER

R-30402 R-1791
Application No. 29885 Permit No. 23754
IN NAME OF

EARL OLIVER

Surveyed 5 NOV. 1958, by M. BISH