


T.32 S.R.5 W.W.M.

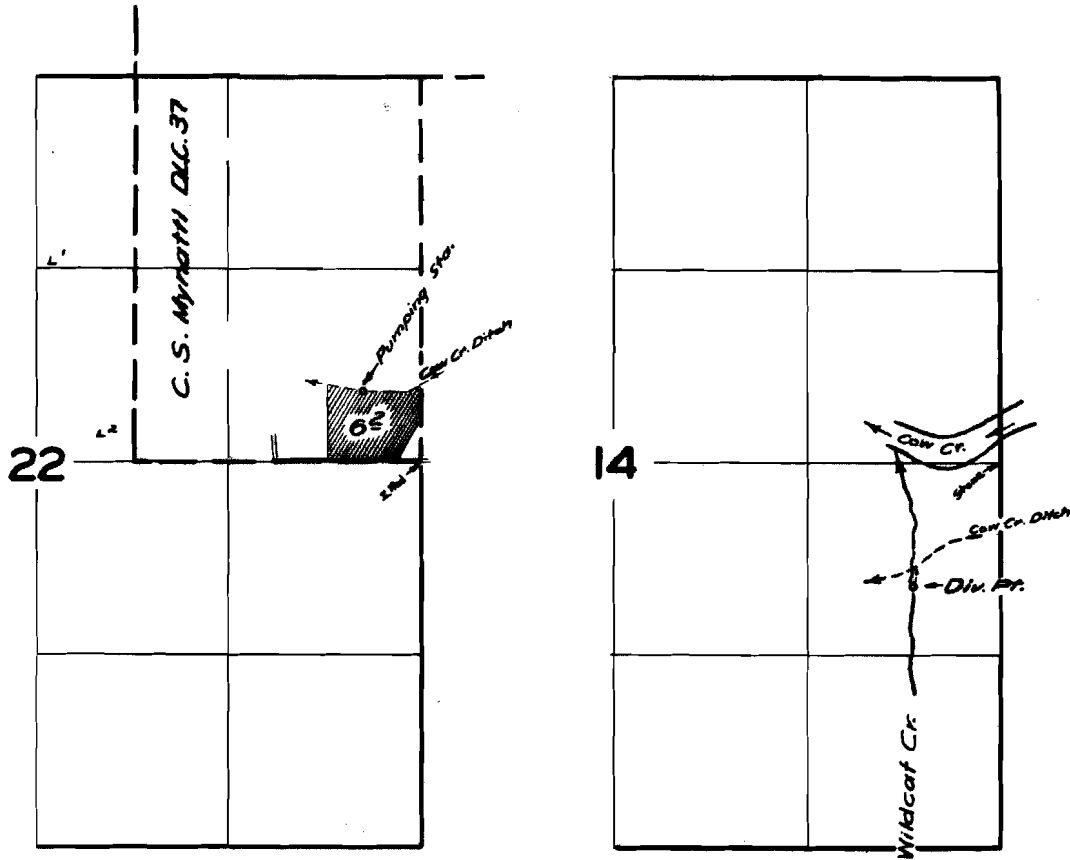

FINAL PROOF SURVEY UNDER

Application No. 30376 Permit No. 23877
IN NAME OF

C.F. Clayton

Surveyed Sept 5 1958, by M. B. Bish