


T.30S.R.6W.W.M.

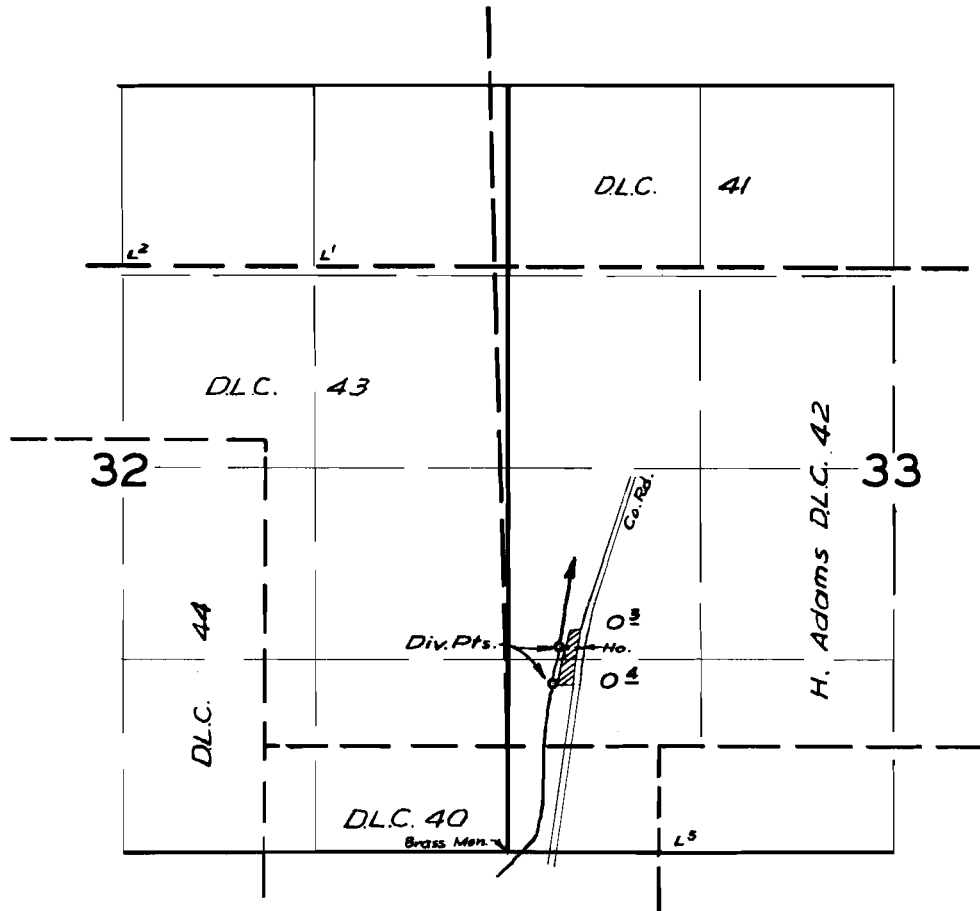

FINAL PROOF SURVEY UNDER

Application No. 30388. Permit No. 23885.
IN NAME OF

JAMES L. HALL

Surveyed 12 Sept. 1958, by M. Bish