


T. 4S. R. 3E. W.M.

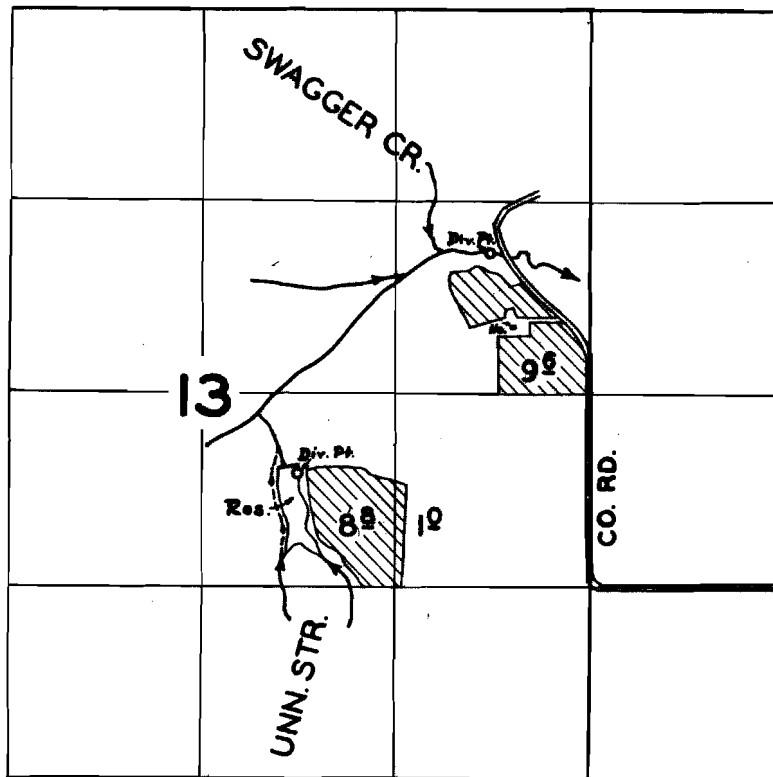

FINAL PROOF SURVEY
UNDER

R-30304 R-1820
Application No. 30305 Permit No. 23971
IN NAME OF

EDMUND M. VAN DYKE

Surveyed 22 AUG. 1958, by M. BISH