


T. 32 S.R.6 W.W.M.

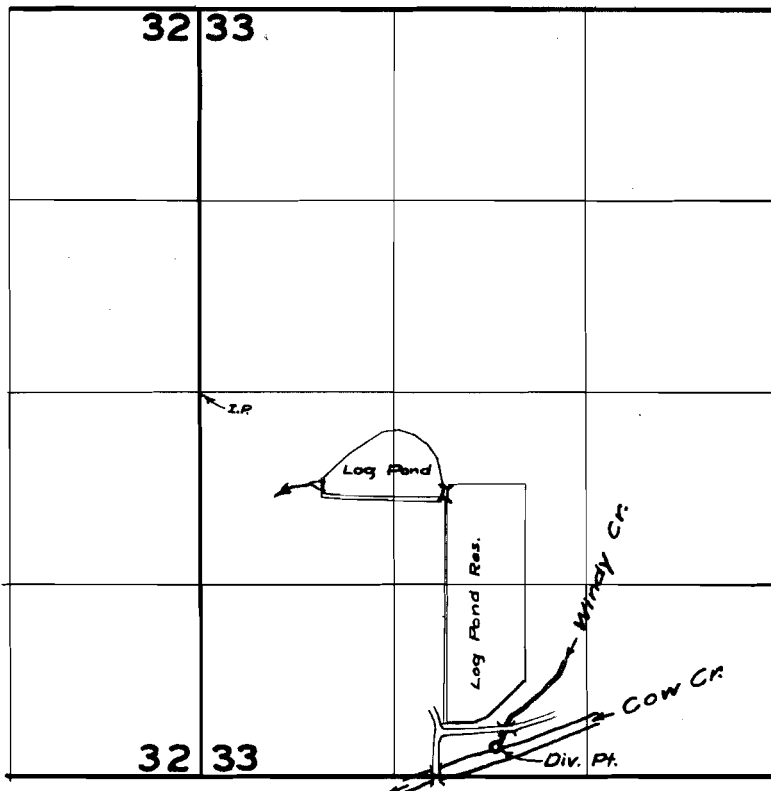

FINAL PROOF SURVEY UNDER

Application No. ^{R-24333} ~~23892~~ Permit No. ^{R-1831} ~~24058~~
IN NAME OF

The Robert Dollar Co.

Surveyed 3 Sept. 1958, by M. Bish