


T.12S.R.4&5W.W.M.

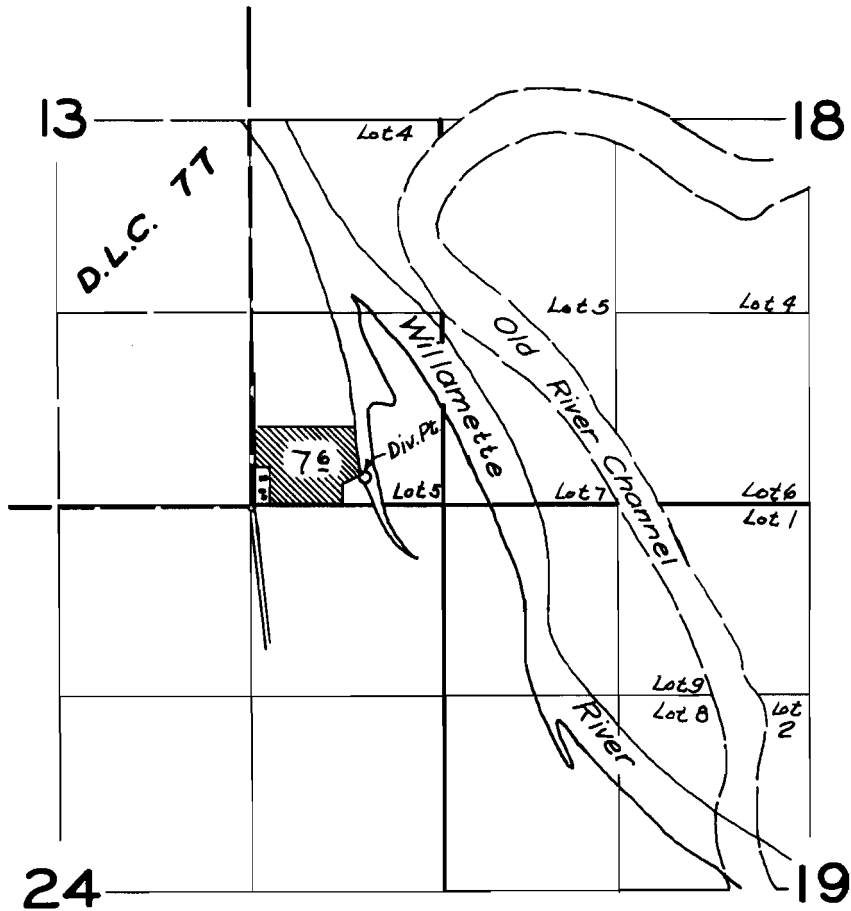

FINAL PROOF SURVEY
UNDER

Application No. 30686 Permit No. 24181
IN NAME OF

H. R. WUTZKE

Surveyed 23 Sept. 1958, by M. Bish

Rf