


T. 12 S.R. 6 W.W.M.

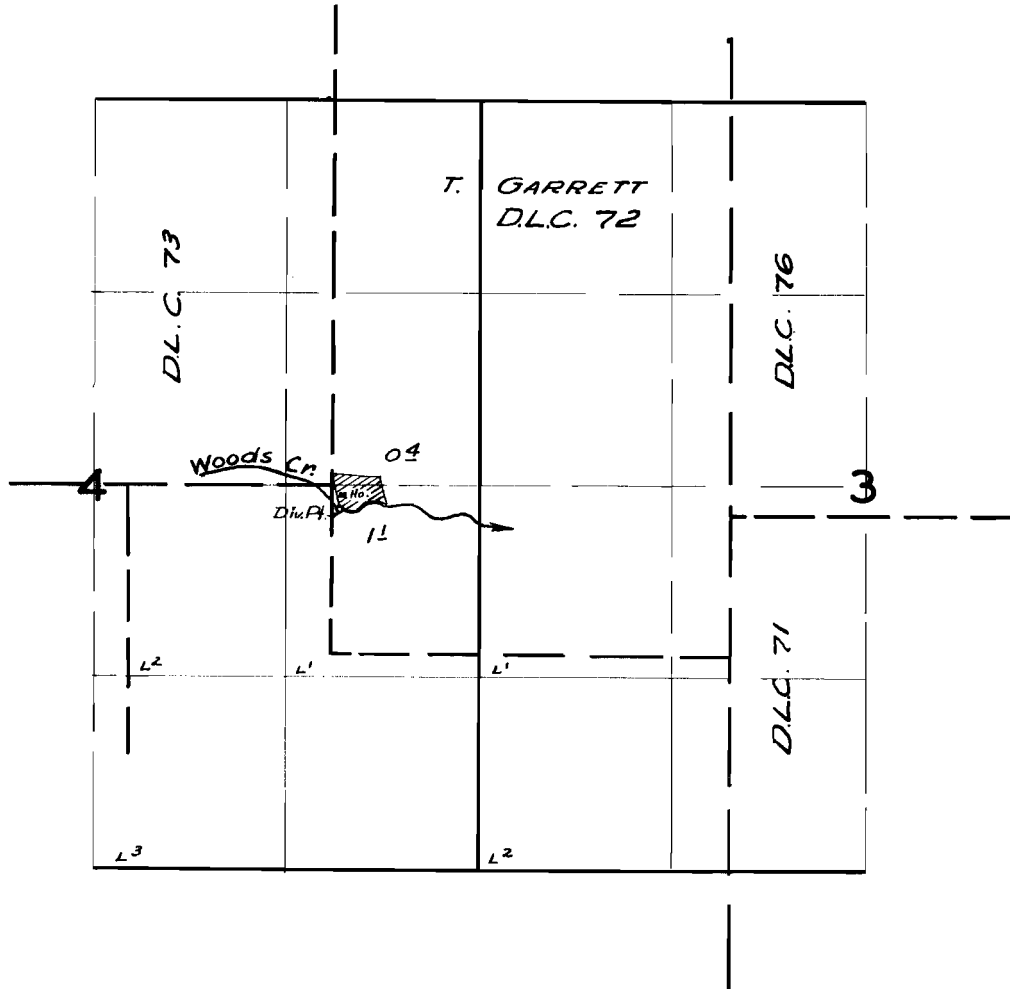

**FINAL PROOF SURVEY**  
UNDER

Application No. 30991 Permit No. 24447  
IN NAME OF

CLYDE W. & ALICE CALLAHAN

Surveyed 17 Sept. 1958, by M. Bish