


T. 30 S.R. 5 W.W.M.

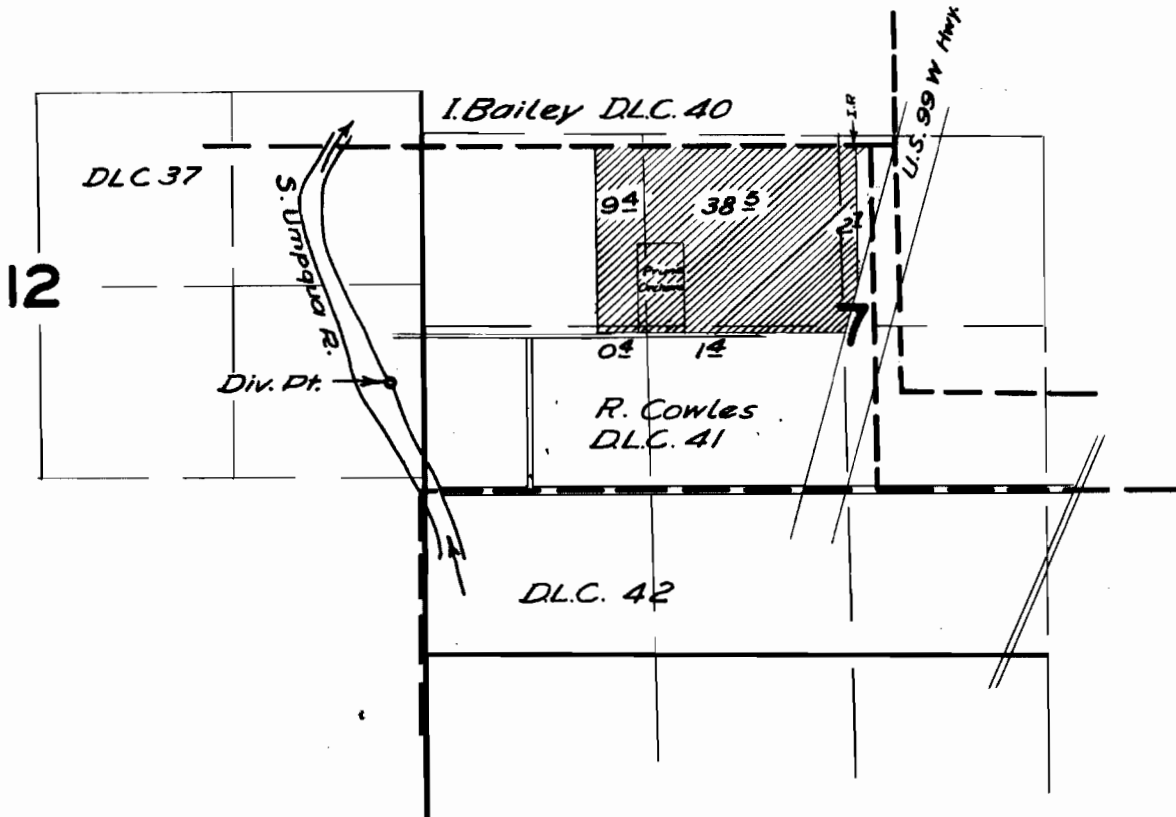

Note: Sec. & DLC. Lines are
Located from Douglas Co. Records

FINAL PROOF SURVEY UNDER

Application No. 31128 Permit No. 24600
IN NAME OF

A. L. MATTHEWS

Surveyed 11 Sept. 1958, by M. Bish