T. 8S. R. 3W. W.M.

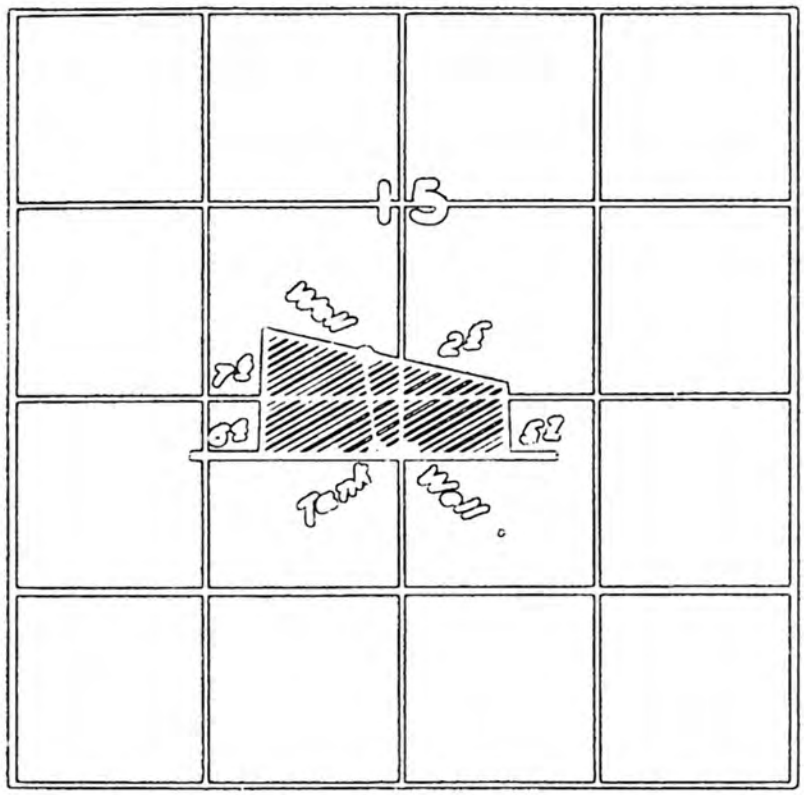

FINAL PROOF SURVEY
UNDER

Application No. O-250 O-104 Permit No. O-167 G-257
IN NAME OF

John B. Woods & Son, Inc.

Surveyed Oct. 7 1938, by W. N. Perry

OFN-30-01