


T. 6S. R. 2W. W.M.

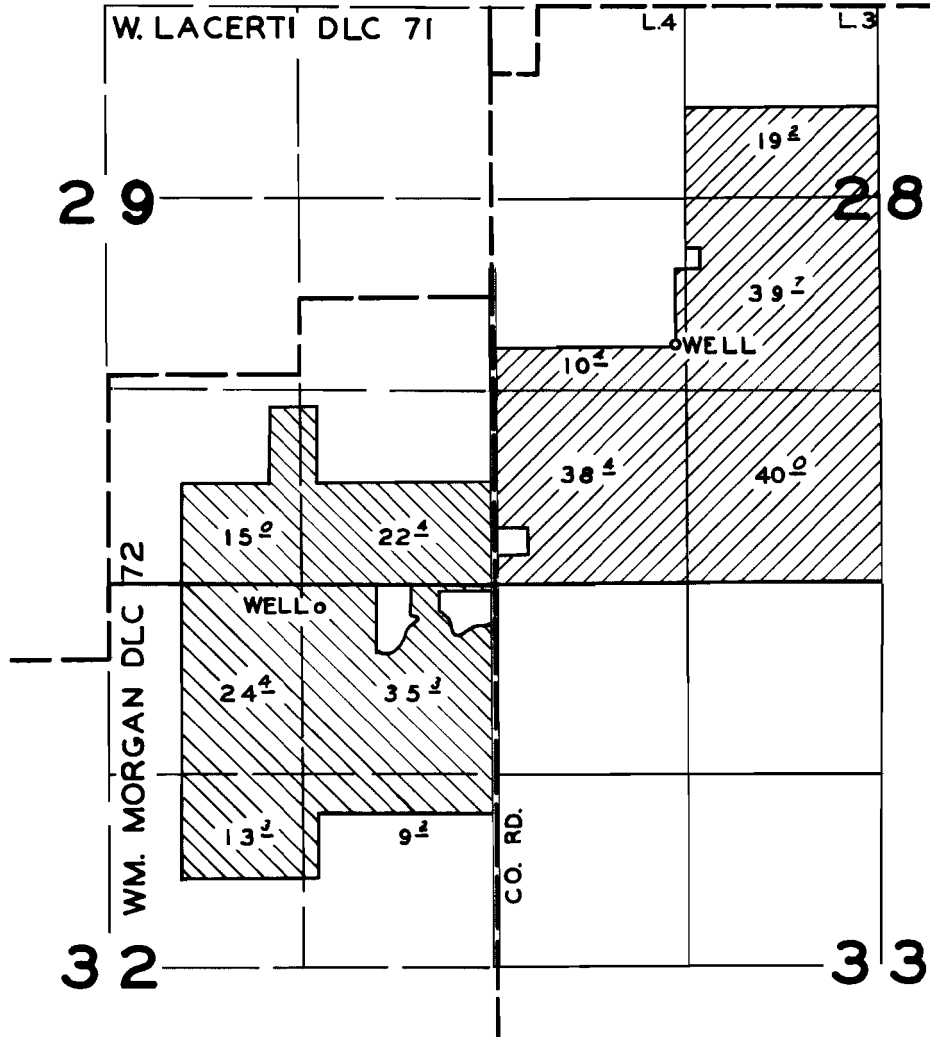

FINAL PROOF SURVEY  
UNDER

Application No. G 259 ~~G 558~~ Permit No. G 163 ~~G 458~~   
IN NAME OF

ALVIN J. VAN CLEAVE

Surveyed MAY 24 1960, by C. O. BARTELS