


T. 8S. R. 3W. W.M.

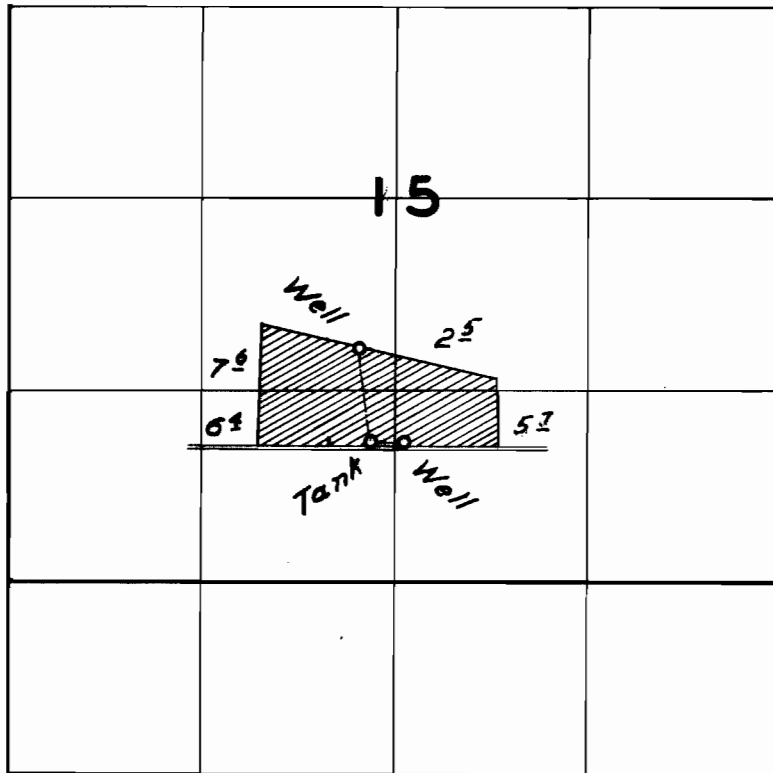

FINAL PROOF SURVEY
UNDER

Application No. *G-258* *G-167*
G-404 Permit No. *G-267*
IN NAME OF

John B. Woods & Son, Inc.

Surveyed *Oct. 7* 1958, by *W. N. Perry*