


T. 8 S. R. 3 W. W.M.

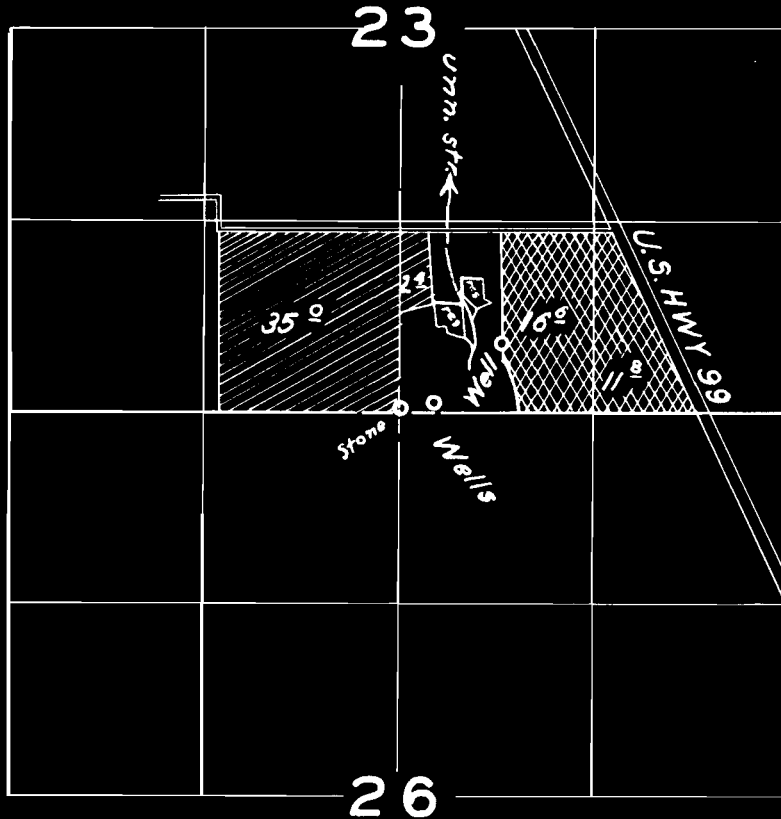

**FINAL PROOF SURVEY**

UNDER

G-483

R-31385

31386

G-353

R-1997

24746



Application No. G-599 Permit No. G-502

IN NAME OF

*John B. Woods & Son, Inc.*

Surveyed Oct. 7 1958, by W.N. Perry