


T. 5S. R. 5W. W.M.

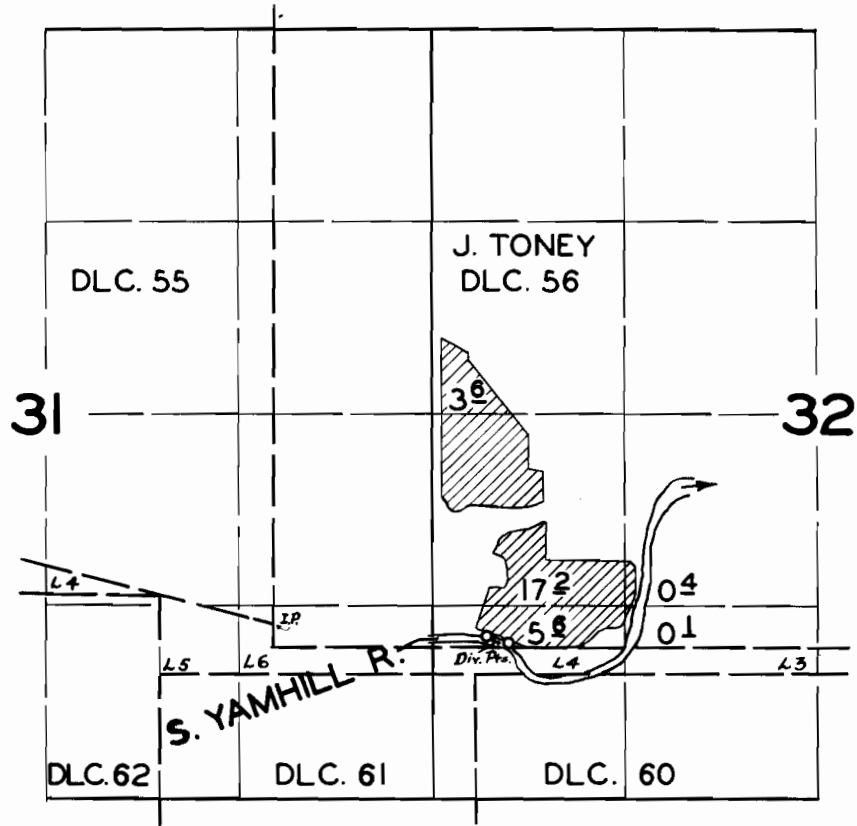

FINAL PROOF SURVEY
UNDER

Application No. 31433 Permit No. 24766
IN NAME OF

A. C. CAMP

Surveyed APR. 4 1958 by M. BISH