


T. 3S. R. 3W. W.M.

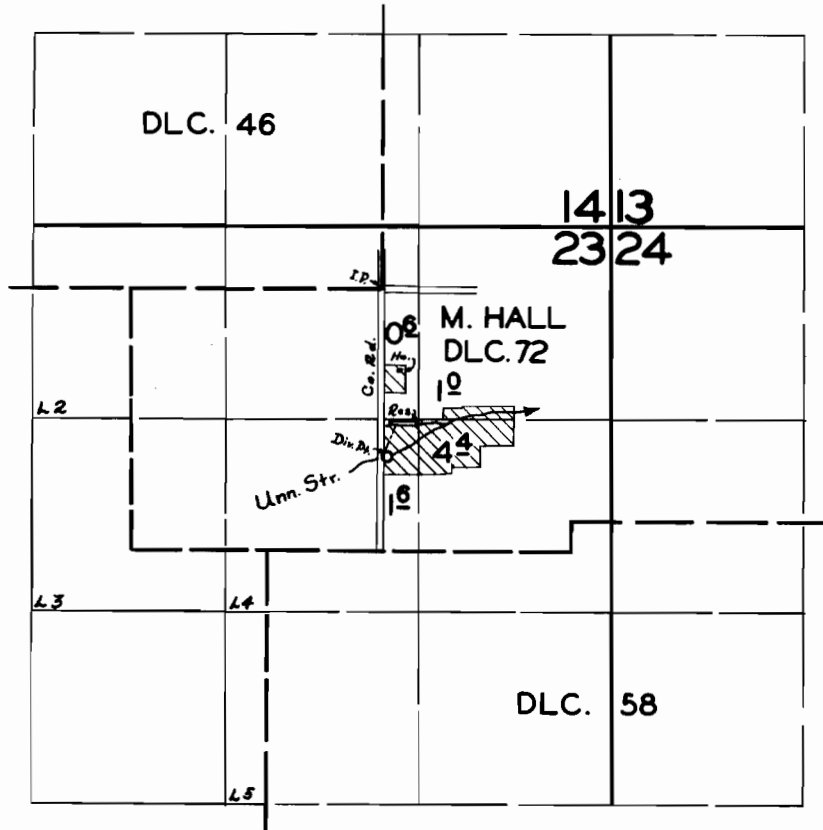

**FINAL PROOF SURVEY**  
UNDER

R-31964 R-2090  
Application No. 31241 Permit No. 25190  
IN NAME OF

**WAYNE D. MOSHER**

Surveyed MAY 15 1958, by M. BISH