


T. 3S. R. 3W. W.M.

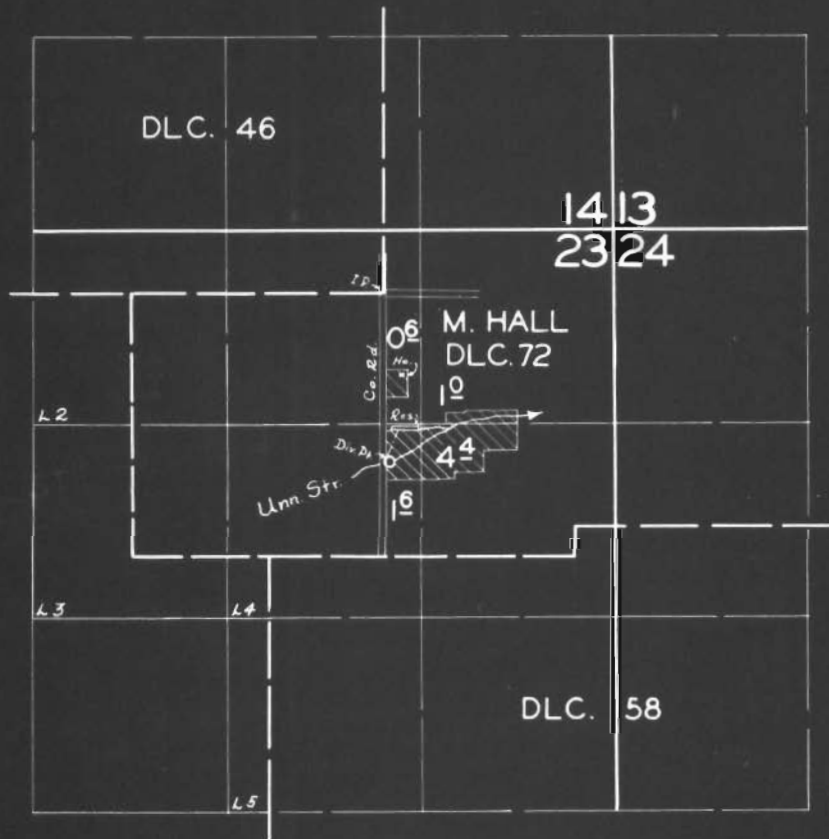

FINAL PROOF SURVEY
UNDER

R-31964 R-2090
Application No. 31241 Permit No. 25190
IN NAME OF

WAYNE D. MOSHER

Surveyed MAY 15 1958, by M. BISH