


T.I.N.R.4 W.W.M.

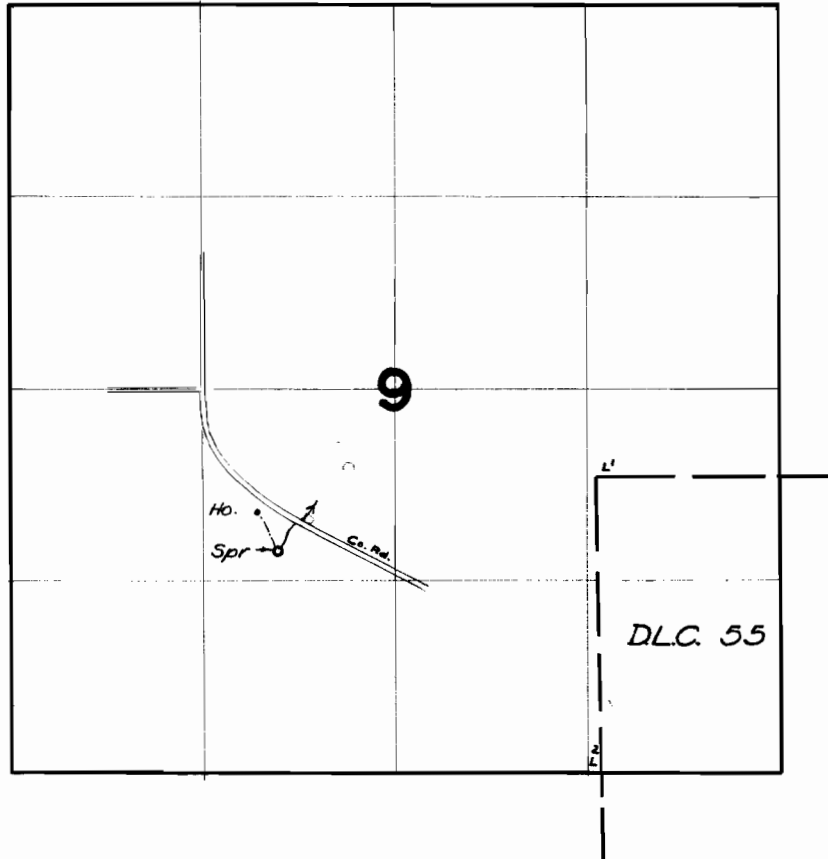

FINAL PROOF SURVEY UNDER

Application No. 32004 Permit No. 25283
IN NAME OF

V. C. & Carrie Clinton

Surveyed 2 July 1958, by M. Bish