


T. 22S. R. 32E. W.M.

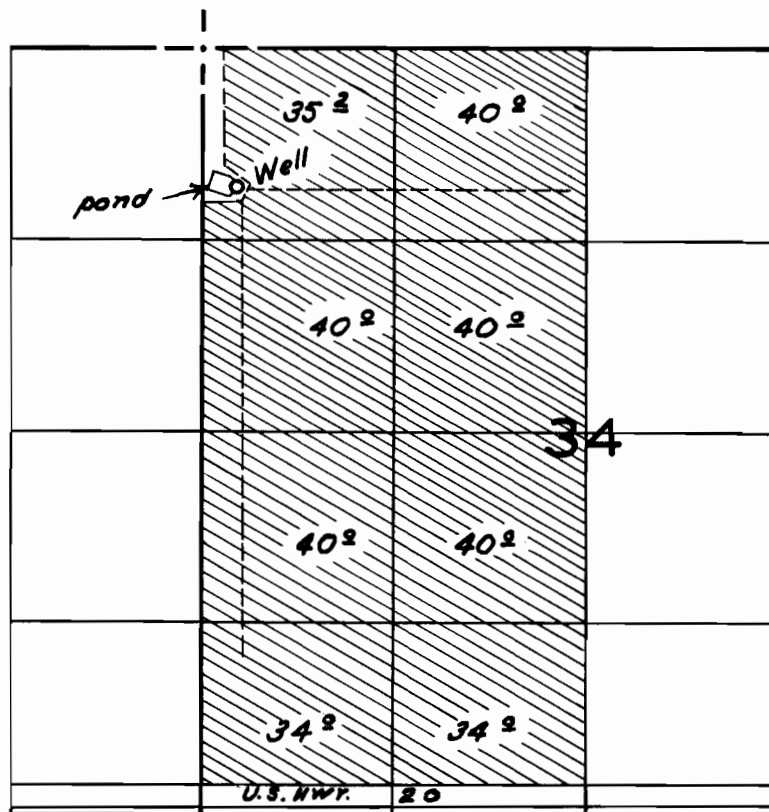

FINAL PROOF SURVEY
UNDER

Application No. U-611 Permit No. U-559
IN NAME OF

Robert W. Davis

Surveyed Aug. 21 1958, by W.N. Perry