


T. 22 S. R. 32 E. W.M.

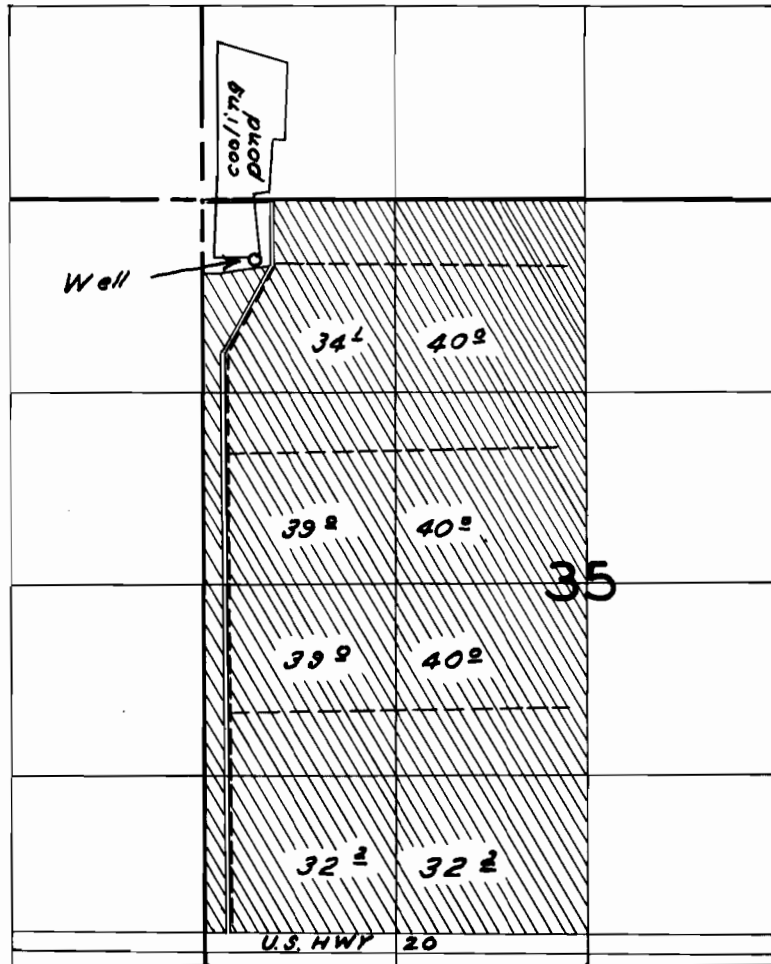

FINAL PROOF SURVEY
UNDER

Application No. U 721 Permit No. U 642
IN NAME OF

Robert W. Davis

Surveyed Aug. 21, 1958, by W. N. Perry