


T. 2 N. R. 16 E. W. M.

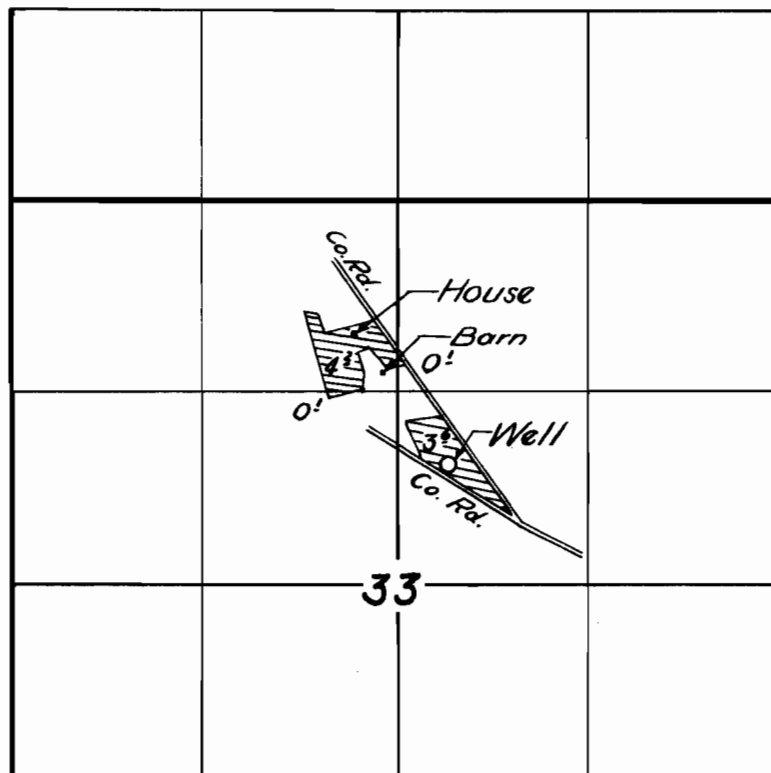

FINAL PROOF SURVEY
UNDER

Application No. U-563 Permit No. U-567
IN NAME OF

ESTATE of VICTOR ANDERSON

Surveyed 11 Apr. 1955, by T. JONES

1955-Z