


T. 9S. R. 2W. W.M.

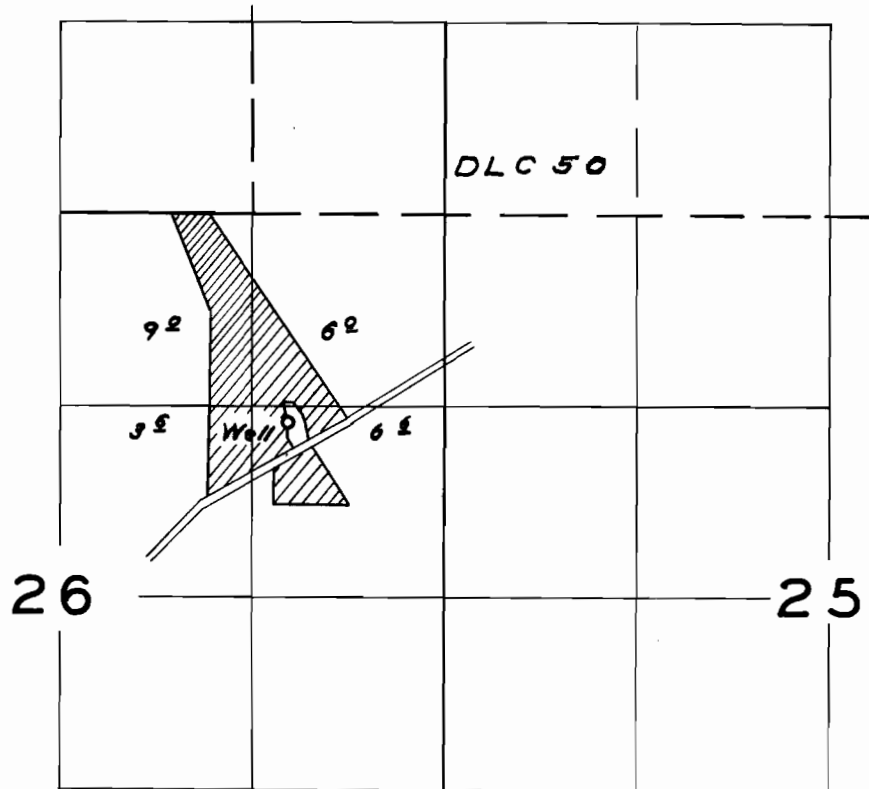

FINAL PROOF SURVEY
UNDER

Application No. G-275 Permit No. G-187
IN NAME OF

Peter J. Kremer

Surveyed Nov. 3, 1958, by W.N. Perry