


T.8S.R.2-3W.W.M.

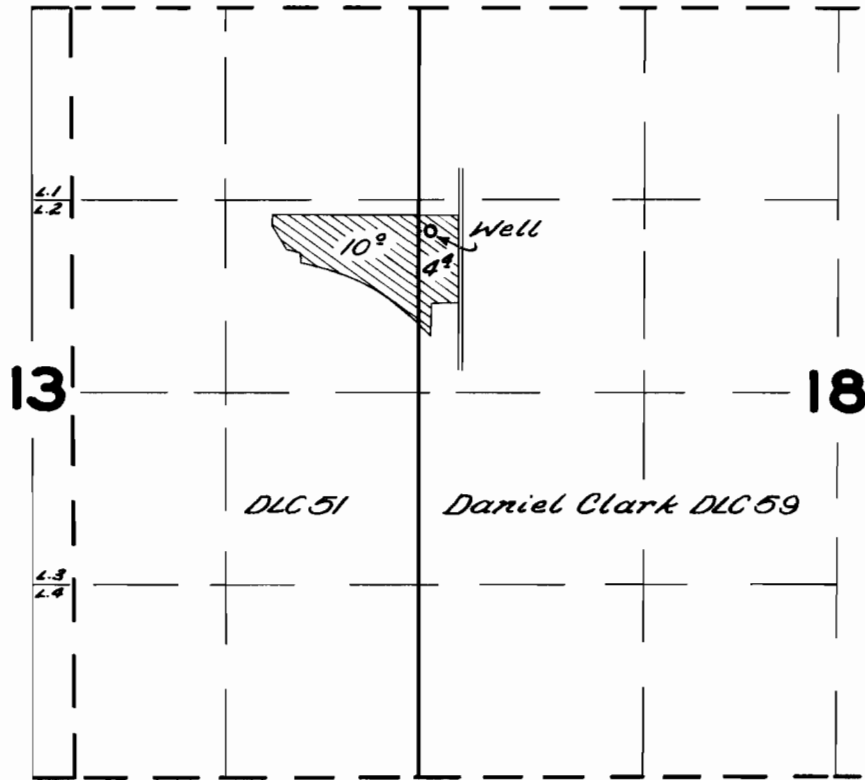

FINAL PROOF SURVEY UNDER

Application No. *G-440* Permit No. *G-316*
IN NAME OF

Gregory Jueden

Surveyed *April 22, 1958*, by *C.O. Baetz*