


T.5S. R.1W.W.M.

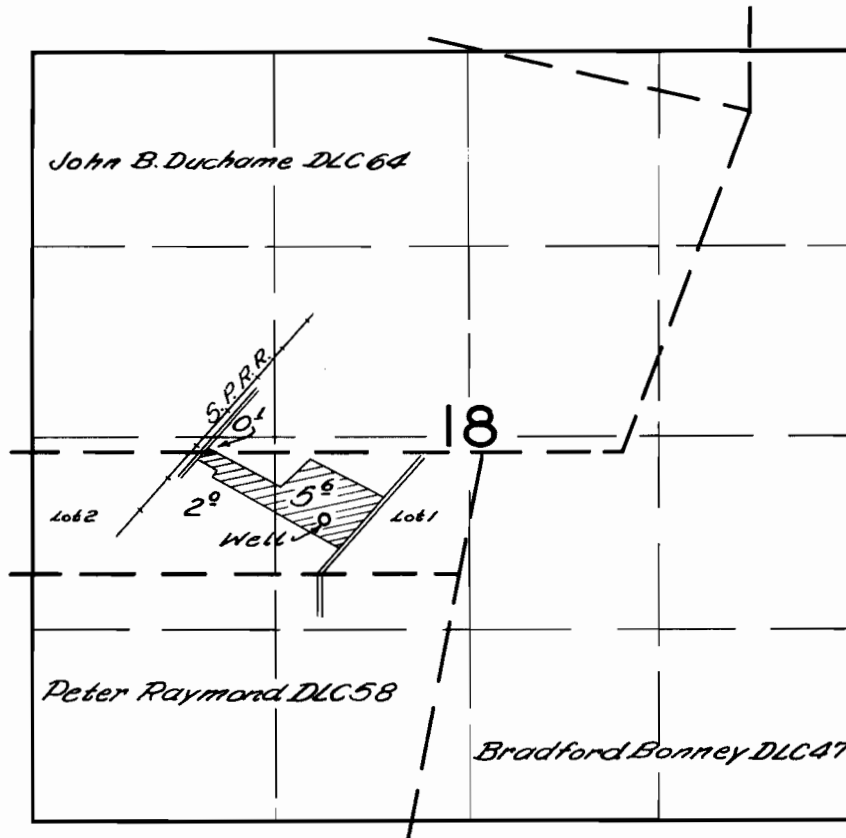

FINAL PROOF SURVEY
UNDER

Application No. G-548 Permit No. G-435
IN NAME OF

Paul I. Ladiayoff

Surveyed April 23 1958, by C.W. Burt