


T.31 S.R.15 W.W.M.

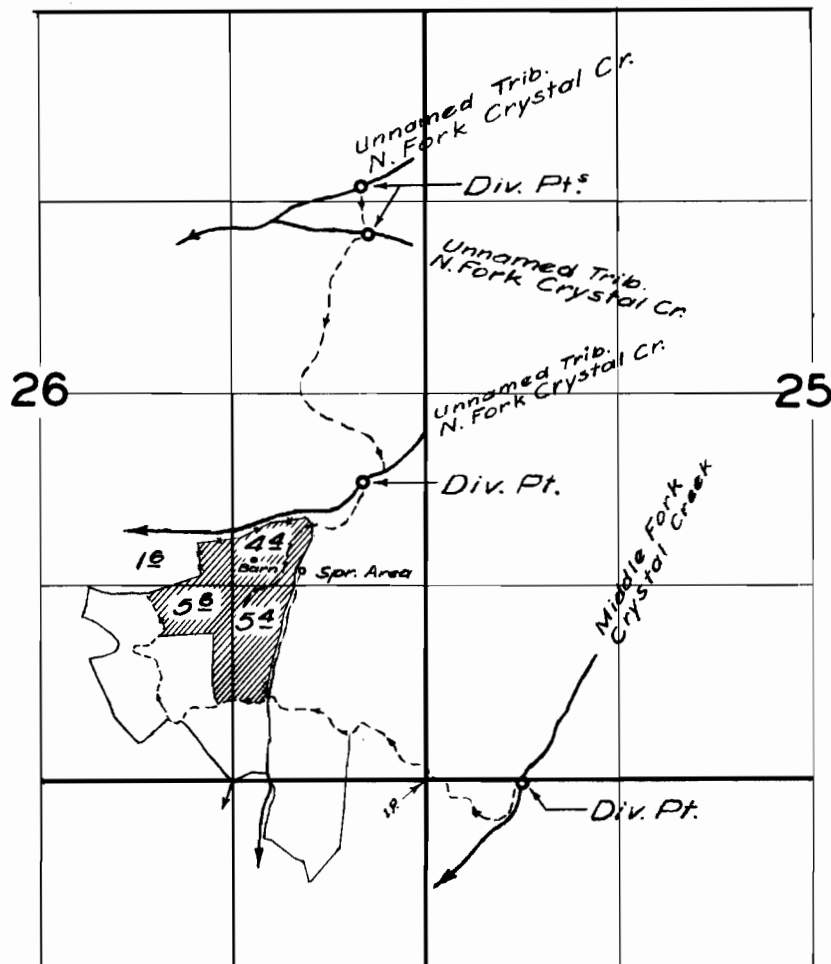

FINAL PROOF SURVEY
UNDER

Application No. 19602 Permit No. 15226
IN NAME OF

Lee L. & Grace E. Stonecypher

Surveyed 21 April 1958, by M. Besh