


T.29 S.R.14 W.W.M.

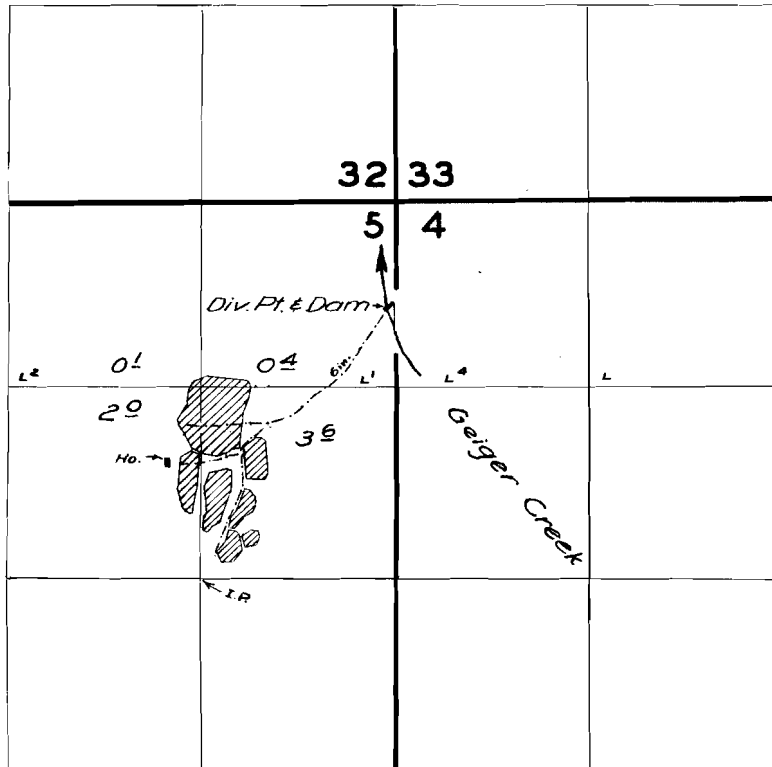

FINAL PROOF SURVEY UNDER

Application No. 20179 Permit No. 15722
IN NAME OF

Rankin-Gould Bag, Inc.

Surveyed 22 May 1958, by M. Bush