


T.29 S.R.11 W.W.M.

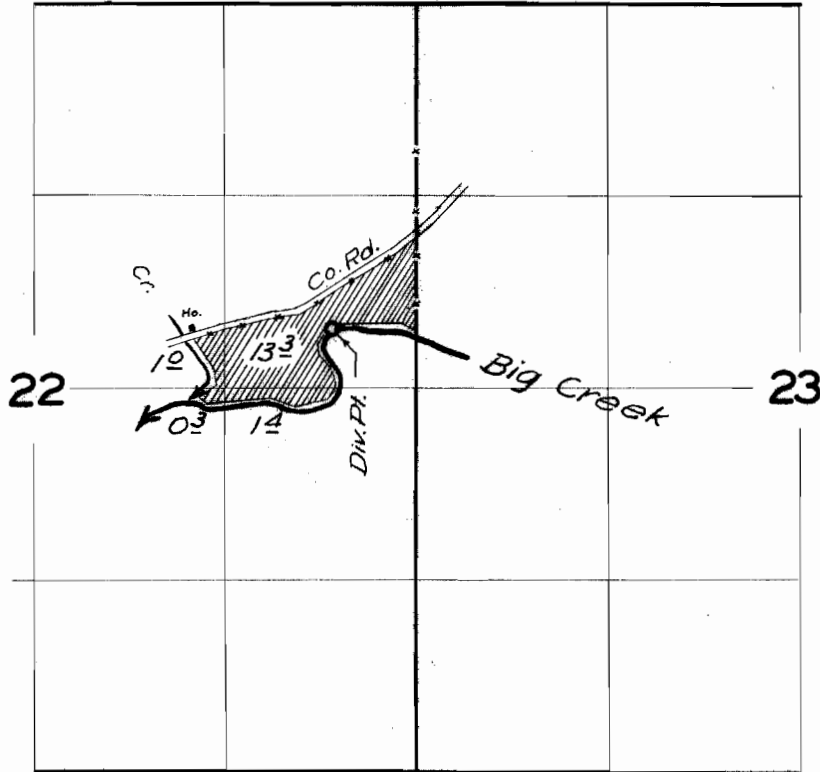

**FINAL PROOF SURVEY**  
UNDER

Application No. 21000 Permit No. 16439  
IN NAME OF

Henry C. Ahrens

Surveyed 13 June 1958, by M. Bish