


T.28 S.R.11 W.W.M.

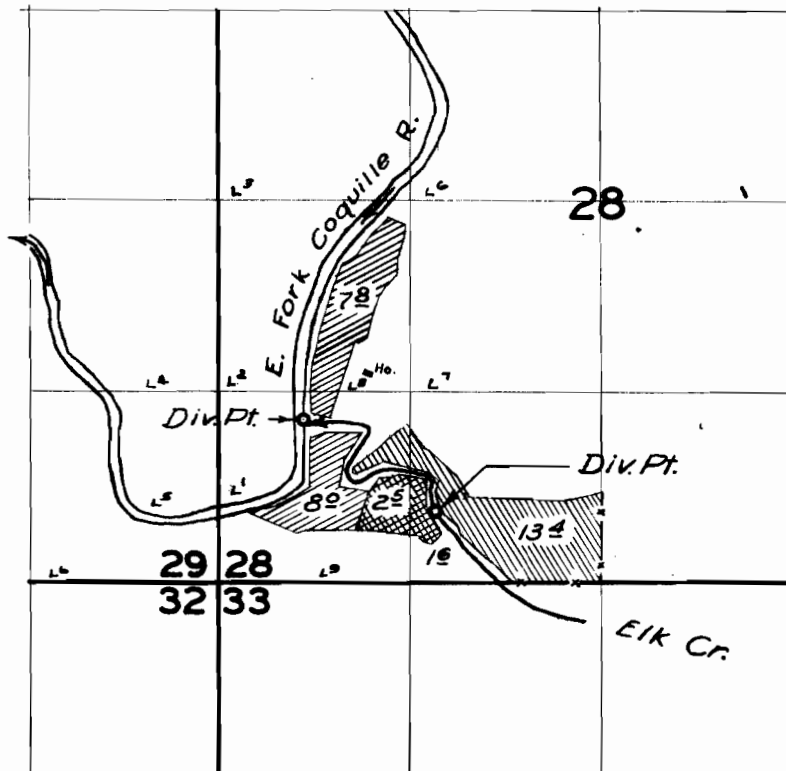

**FINAL PROOF SURVEY**  
UNDER

Application No. 21212 Permit No. 16626  
IN NAME OF

C. Vernon Taylor et ux.

Surveyed 16 June 1958, by M. A. Bish