


T.27S.R.14W.W.M.

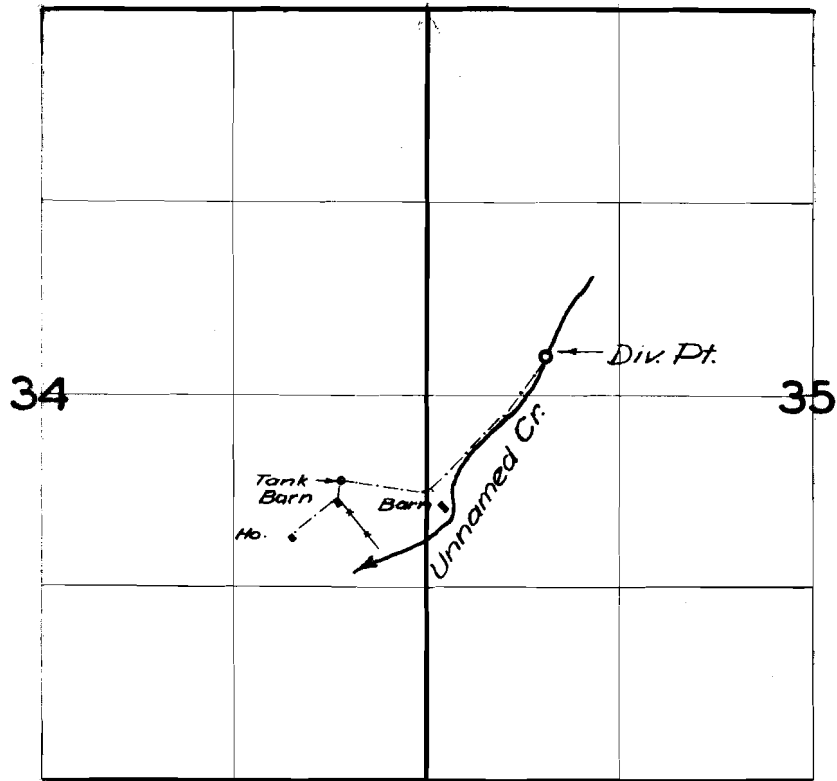

FINAL PROOF SURVEY UNDER

Application No. 21290 Permit No. 16694
IN NAME OF

C. J. Gulseth

Surveyed 10 June 1958, by M. Bish