


T.28 S.R.12 W.W.M.

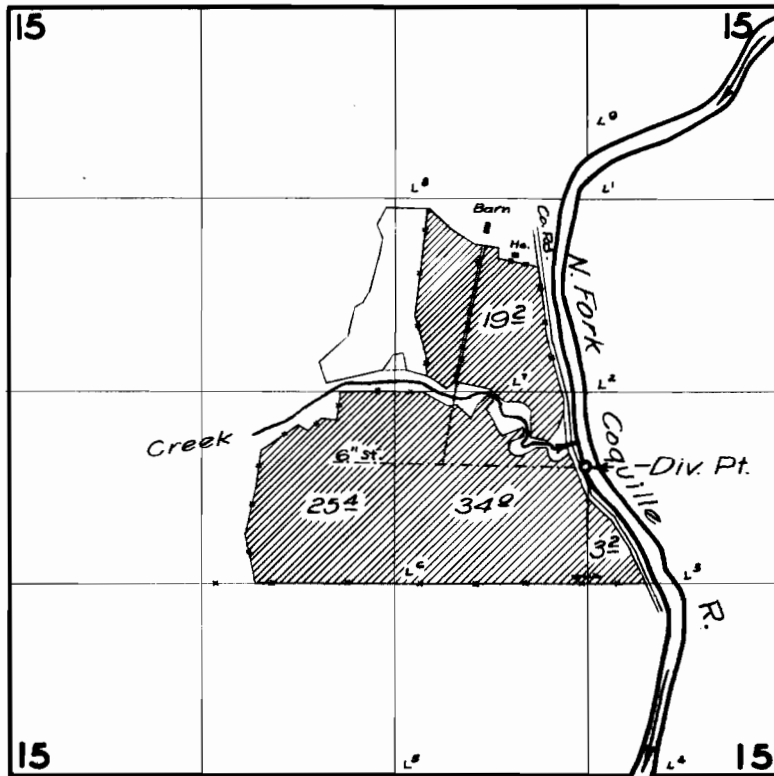

FINAL PROOF SURVEY
UNDER

Application No. 22783 Permit No. 17944
IN NAME OF

Mrs. Josephine Bestul

Surveyed 26 May 1958, by Tr. Bish