


T. 23S. R. 32E. W.M.

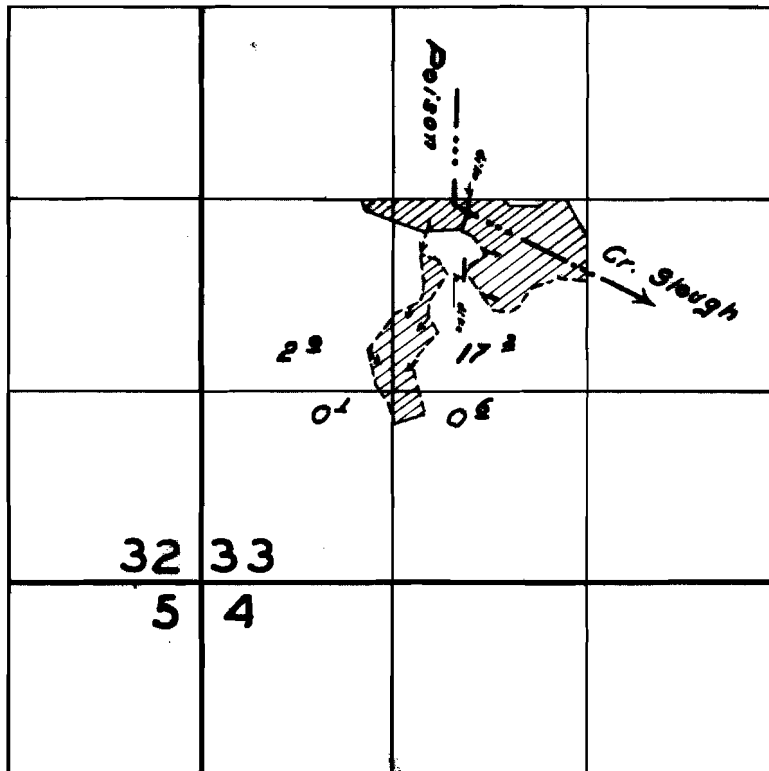

FINAL PROOF SURVEY
UNDER

Application No. 24018 Permit No. 18939
IN NAME OF

John Wood

Surveyed July 22 1958, by W.N. Perry