


T.12S. R.5W.W.M.

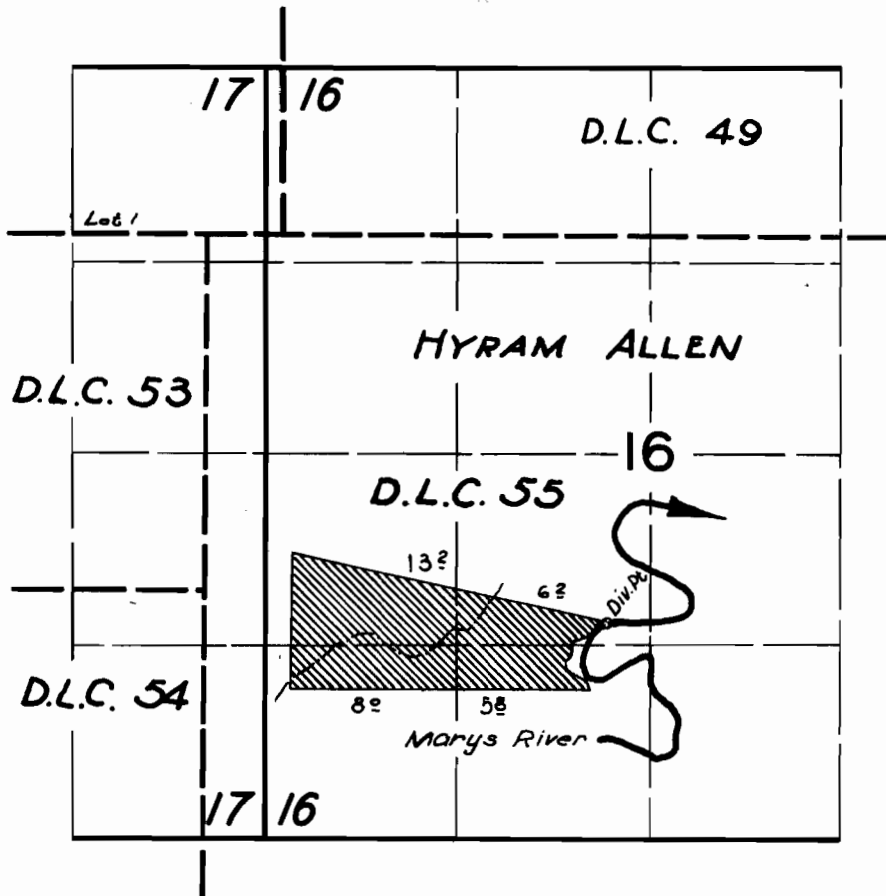

**FINAL PROOF SURVEY**  
UNDER

Application No. 24291 Permit No. 19054  
IN NAME OF

**HOWARD L. CROFF**

Surveyed 6 OCT. 1958, by C.O. BARTELS