


T. 25S. R. 35E. W.M.

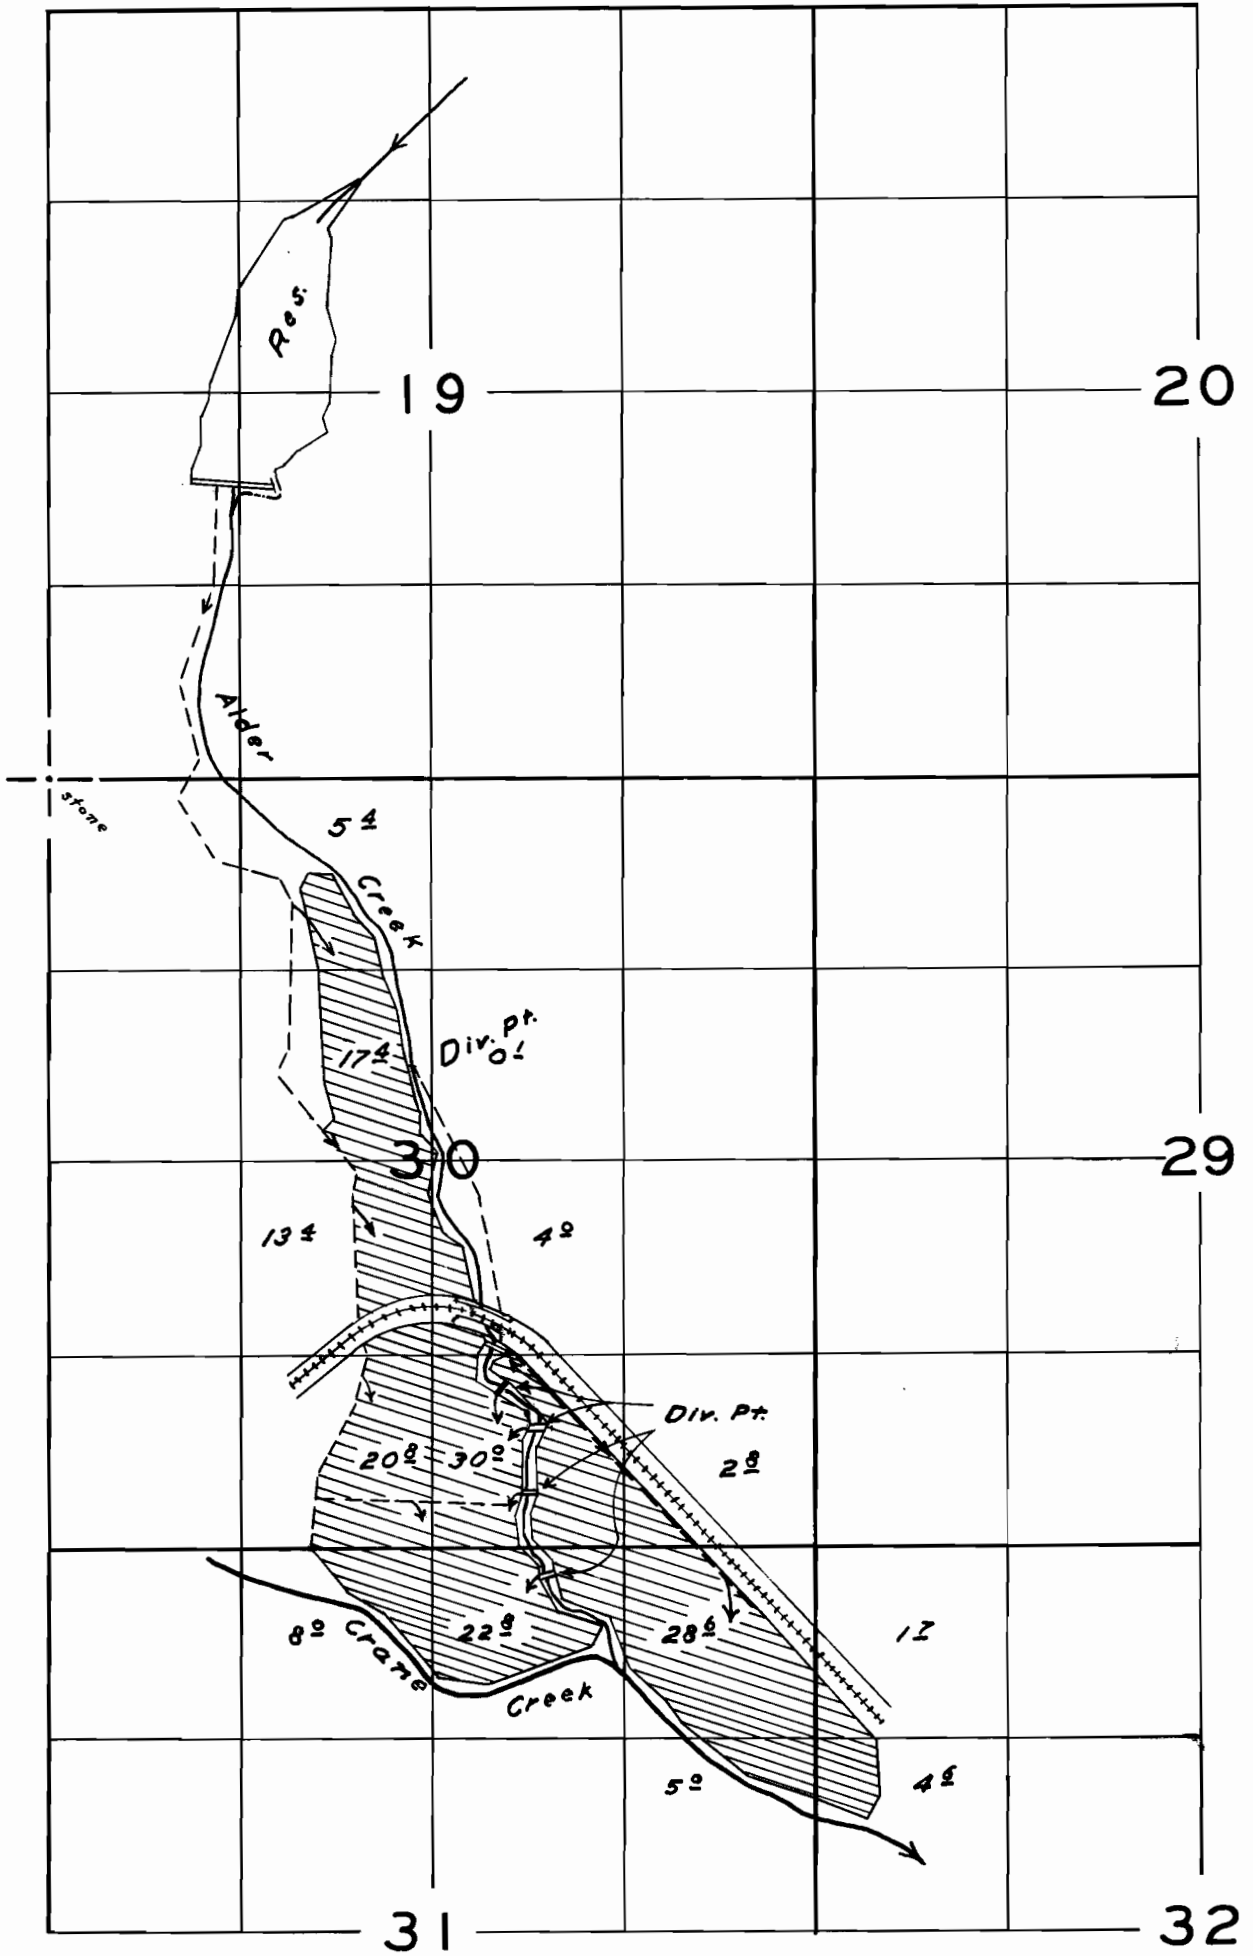

FINAL PROOF SURVEY

UNDER

R-24736

R-1044

Application No. 24737 Permit No. 19504

IN NAME OF

Loyd H. Hill

Survey: Sept 18 1958, by W.N. Perry