


T.6 S. R.1W.W.M.

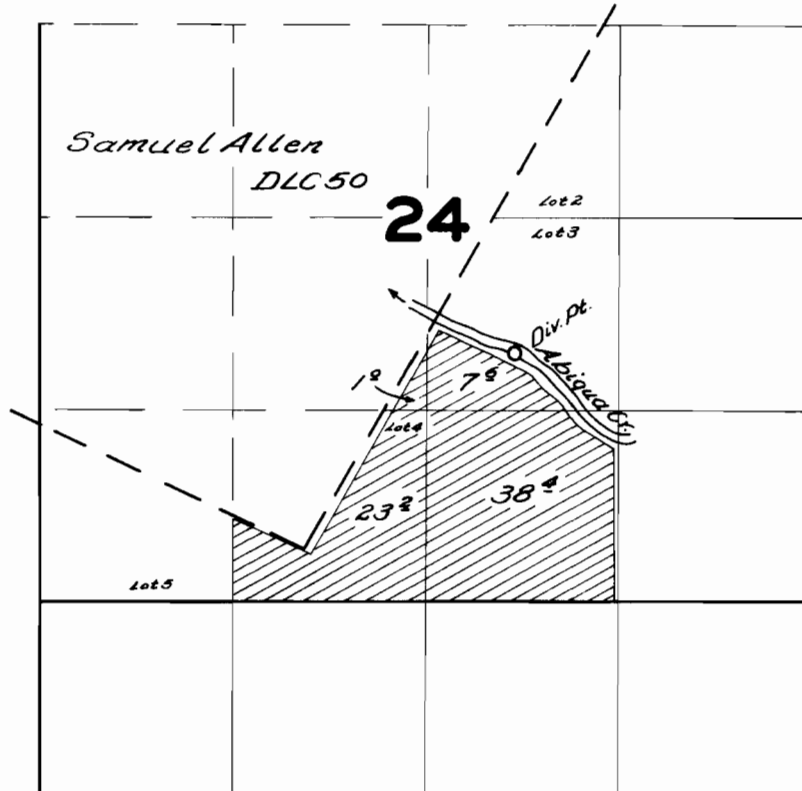

FINAL PROOF SURVEY UNDER

Application No. 24966 Permit No. 19695...
IN NAME OF

Estate of Kenneth A. Setness...

Surveyed April 21, 1958, by C.O. Bartels...