


T. 30 S. R. 11 W. W. M.

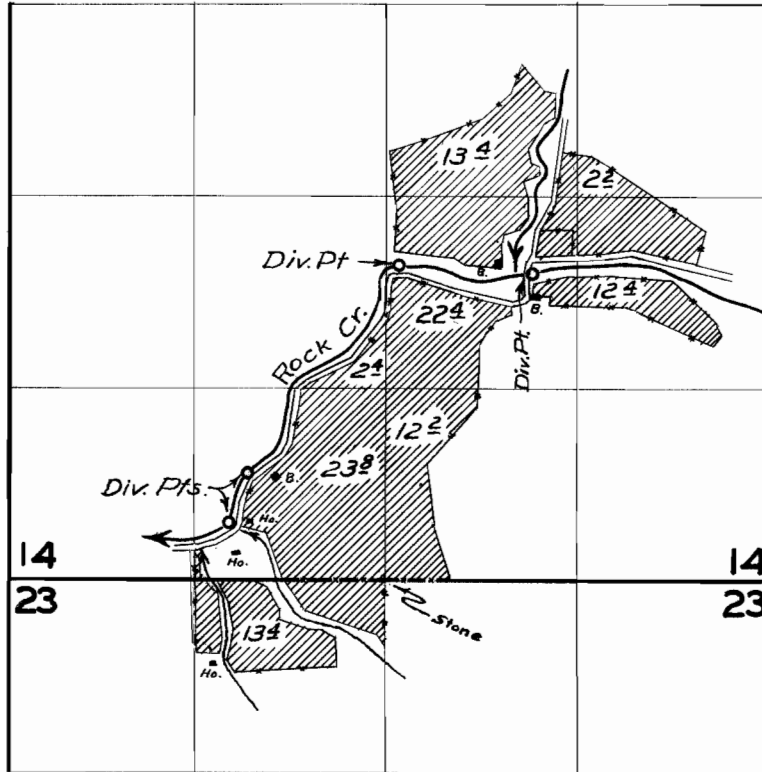

Sheet 1 of 3


FINAL PROOF SURVEY
UNDER

Application No. 25141 Permit No. 19779
IN NAME OF

Leona G. Bryant

Surveyed 9 & 10 July 1958, by Tom Bish

T30SR I I WWM

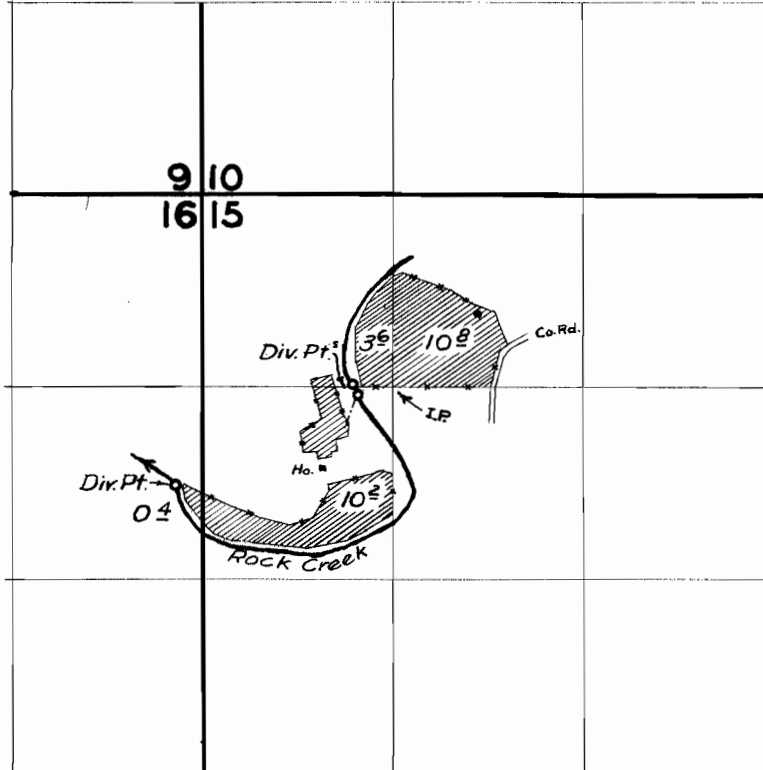

Sheet 2 of 3


FINAL PROOF SURVEY UNDER

Application No. 25141..... Permit No. 19779.....
IN NAME OF

Leona G. Bryant.....

Surveyed 9 & 10 July 1958, by M. Bish.....

T.30S.R.10W.W.M.

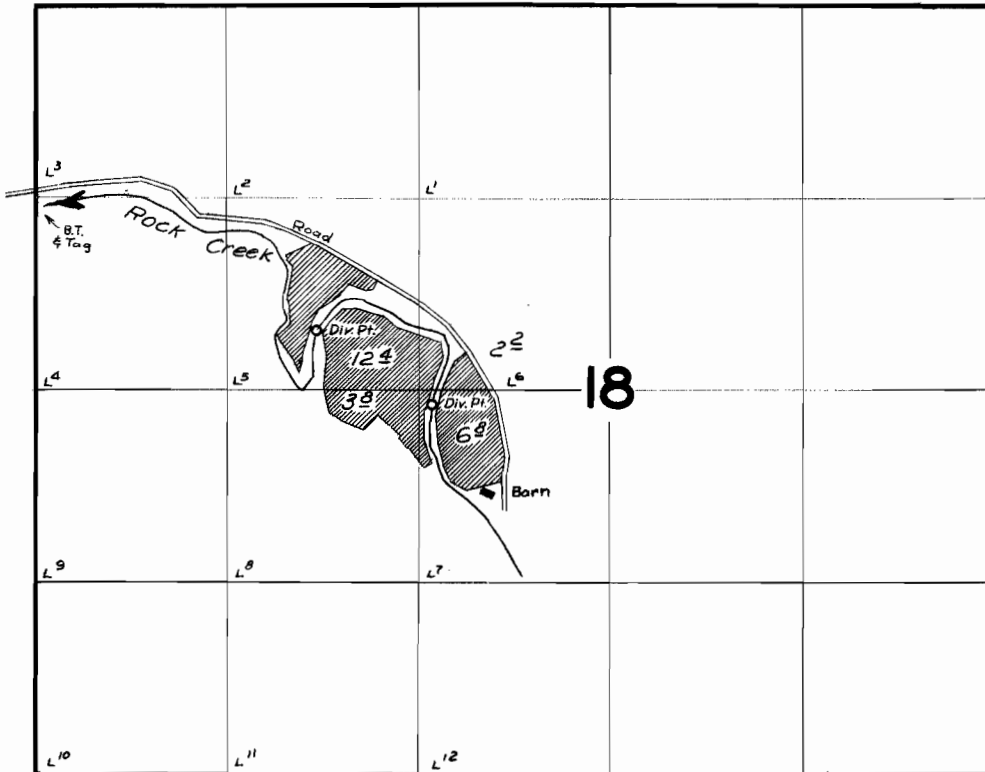

Sheet 3 of 3

FINAL PROOF SURVEY UNDER

Application No. 25141 Permit No. 19779
IN NAME OF

Leona G. Bryant

Surveyed 9¹⁰ July 19.58, by *M. Bish*