


T.24 S.R.13 W.W.M.

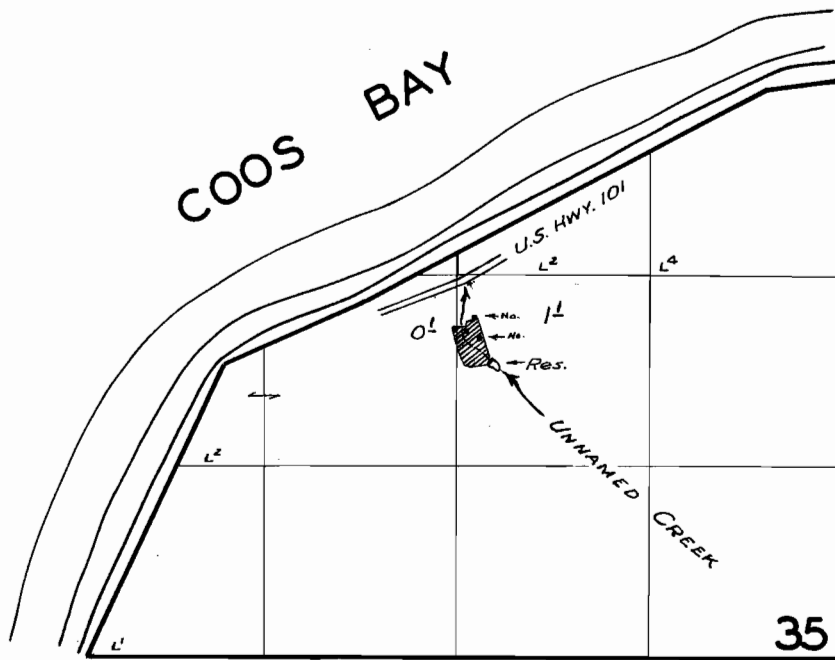

FINAL PROOF SURVEY
UNDER

Application No. 25374 Permit No. 19991
IN NAME OF

Dale H. Foord

Surveyed 12 July 1958, by M. Bish