


T. 2S. R. 2E. W.M.

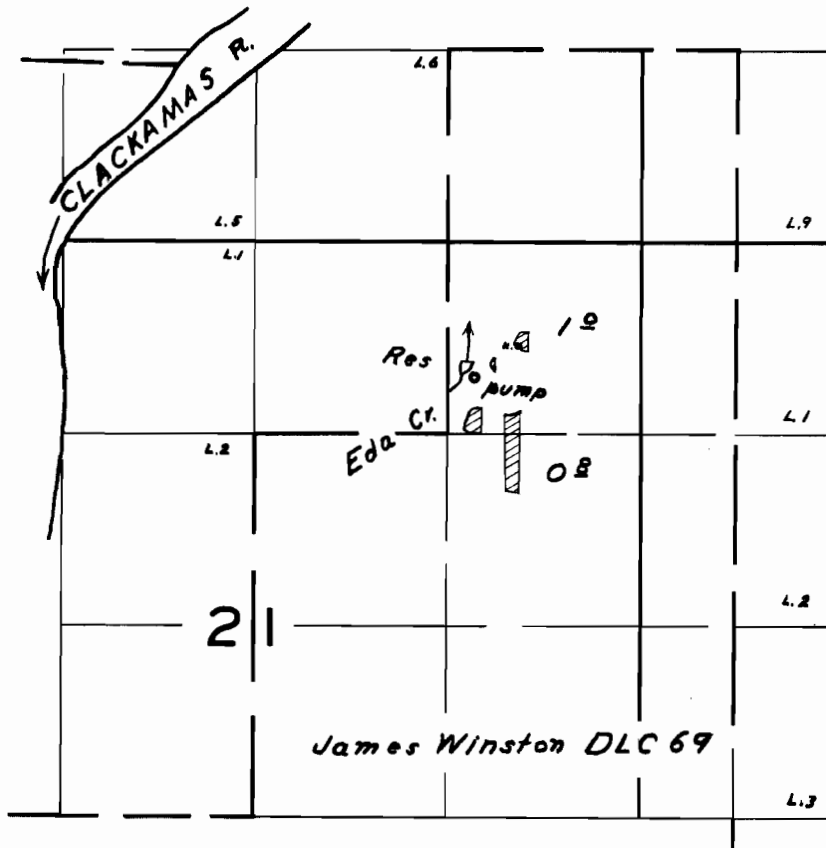

FINAL PROOF SURVEY
UNDER

R-26339 R-1241
Application No. 26340 Permit No. 20666
IN NAME OF

Lawrence C. Personett

Surveyed July 8, 1958, by W.N. Perry