


T. 3N. R. 4W.W.M.

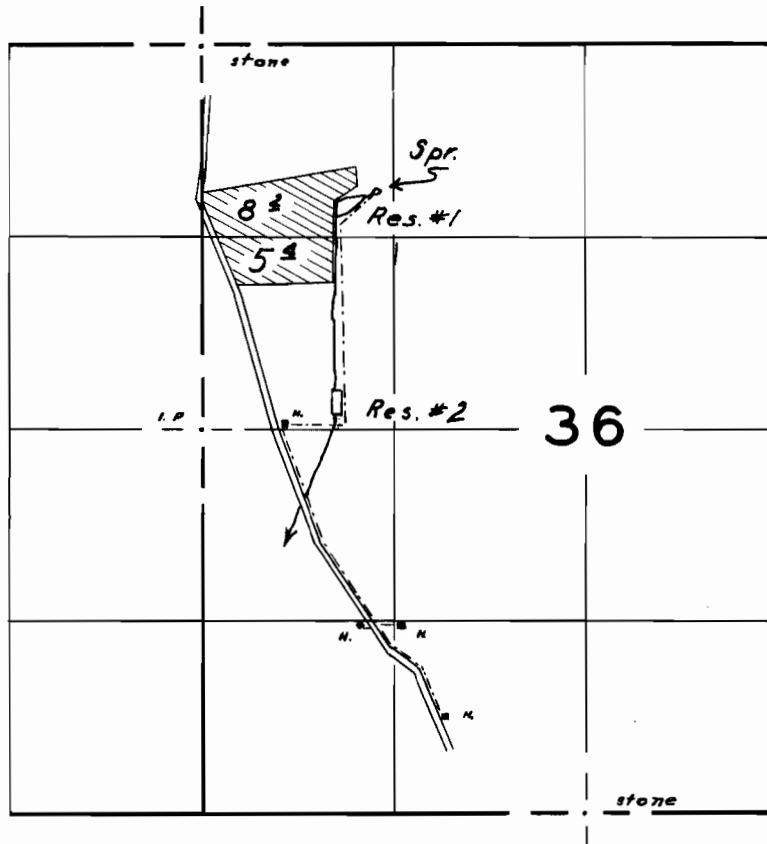

FINAL PROOF SURVEY
UNDER

Application No. R-26267 25889 Permit No. R-1352 21239
IN NAME OF

E. W., Lewis & Wm. M. Kelly

Surveyed May 8 1958, by R.H. Whitby