


T.28 S.R.11 W.W.M.

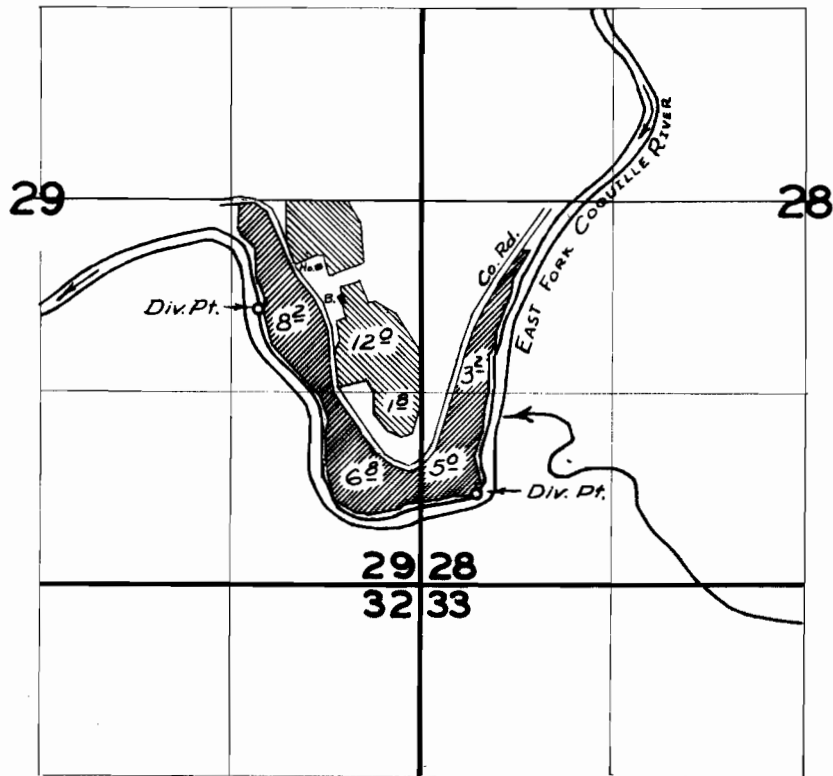

FINAL PROOF SURVEY UNDER

Application No. 27151 30539 Permit No. 21353 24046
IN NAME OF

SEVERT IVERSON

Surveyed 11 July 1958, by M. Bish