


T.3S. R.3E.W.M.

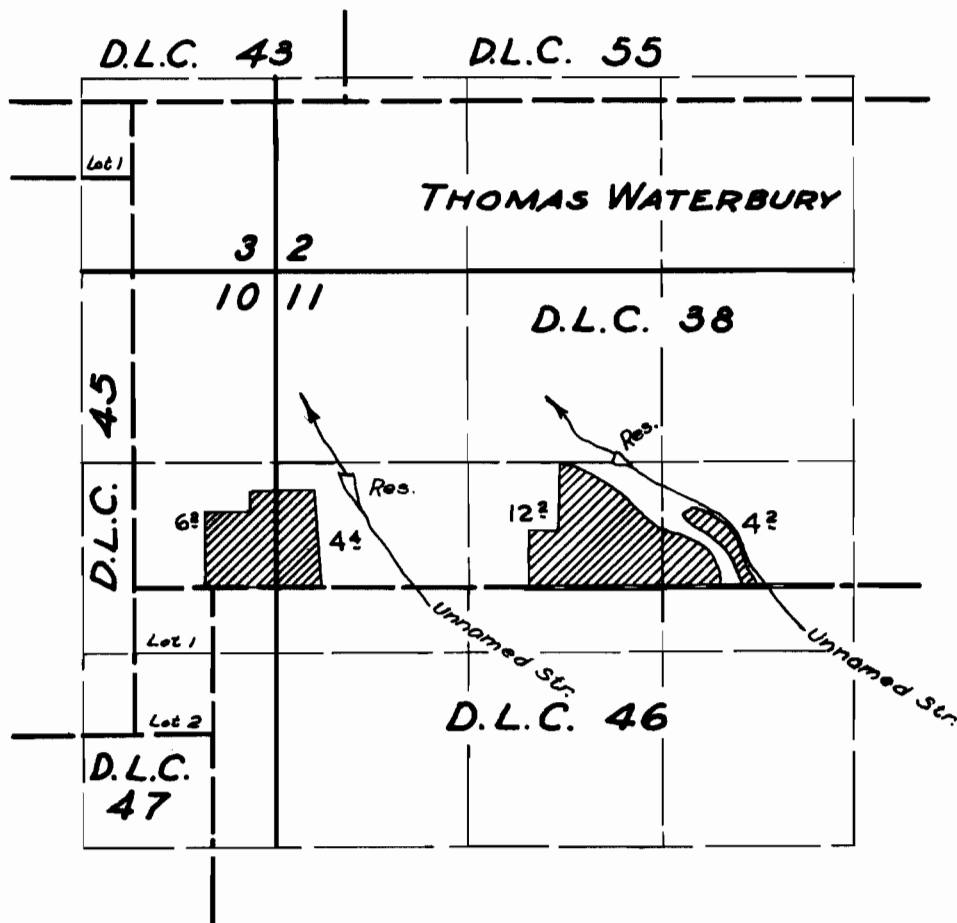

FINAL PROOF SURVEY
UNDER

R-27012 R-1382
Application No. 27013 Permit No. 21515
IN NAME OF

MELVIN A. WELKER

Surveyed 9 Oct. 1958, by C.O. Bartels