


T.28 S.R.10 W.W.M.

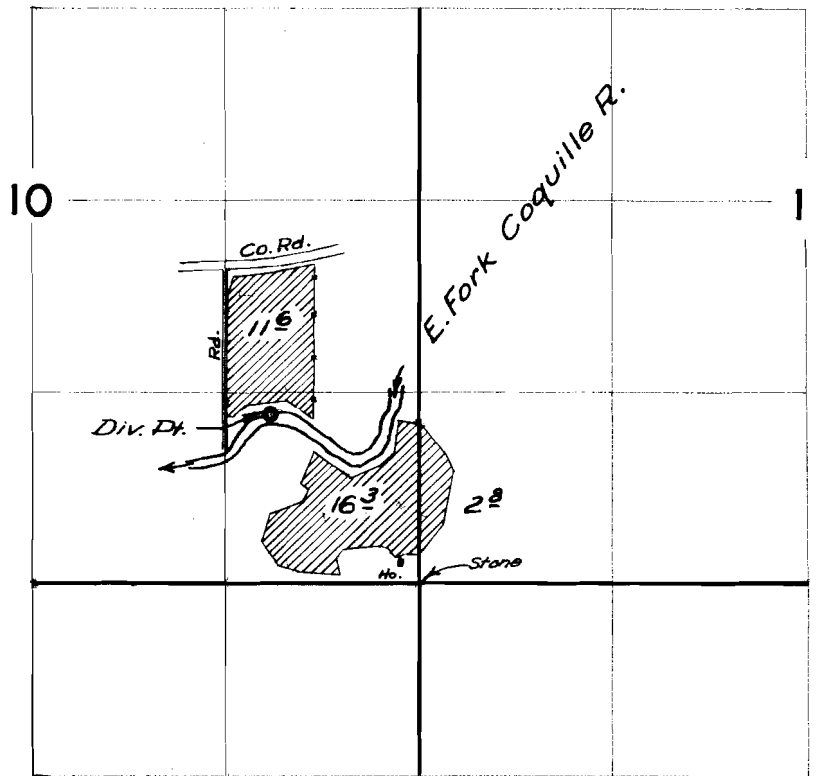

FINAL PROOF SURVEY
UNDER

Application No. 27399 Permit No. 21564
IN NAME OF

W. A. Nickason

Surveyed 16 June 1958, by Tom Bish