


T.32 S.R.15 W.W.M.

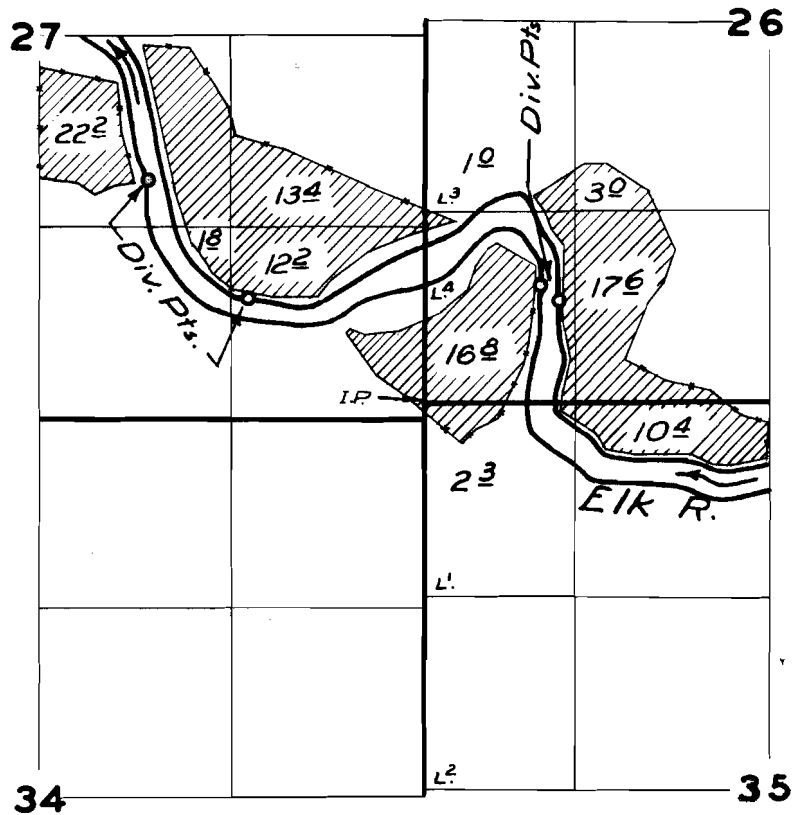

**FINAL PROOF SURVEY**  
UNDER

Application No. 27510 Permit No. 21647  
IN NAME OF

N. B. Marsh

Surveyed 18 April 1958, by M. B. Bish