


T.11 S.R.5 W.W.M.

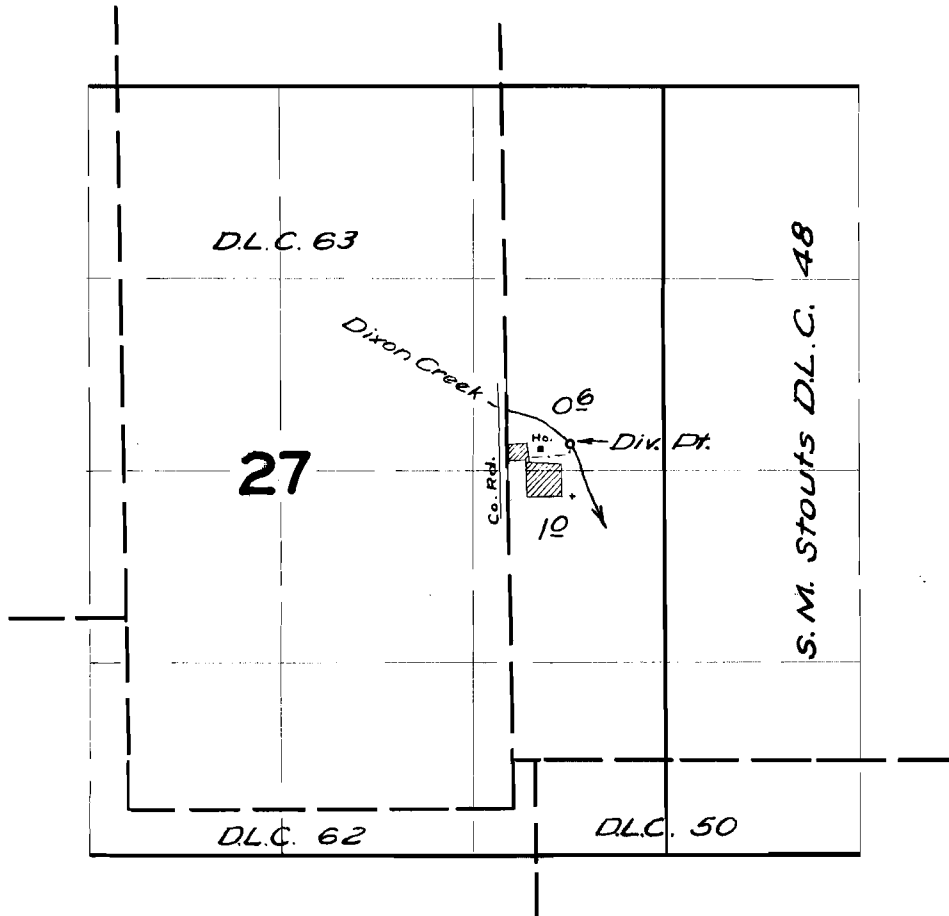

FINAL PROOF SURVEY
UNDER

Application No. 27543 Permit No. 21680
IN NAME OF

Myron G. Cropsey

Surveyed 25 Sept. 1958, by M. Bishop