


T.14S. R.1W.W.M.

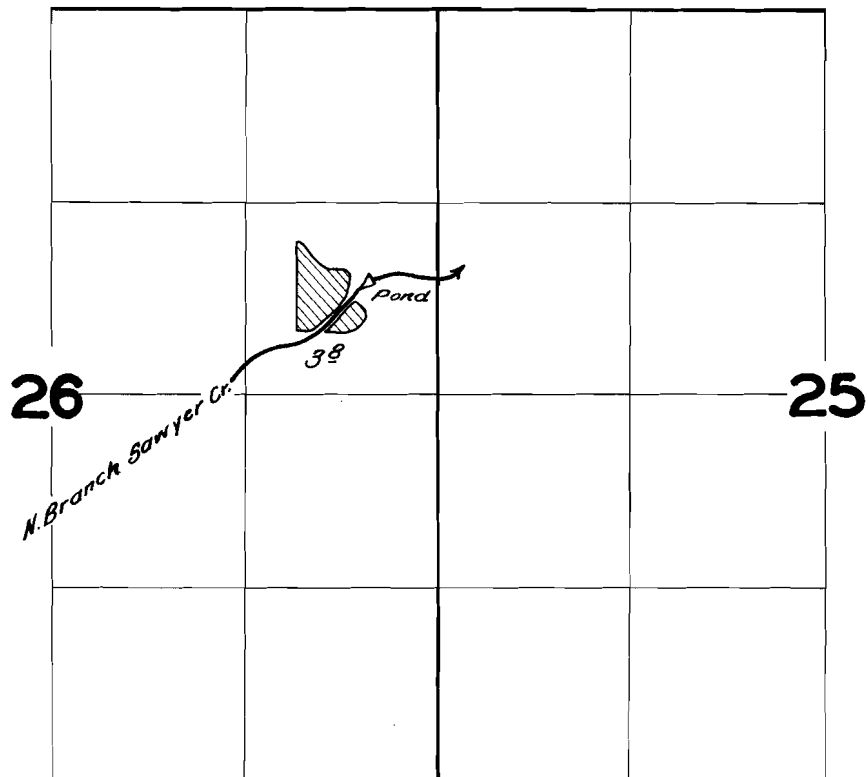

FINAL PROOF SURVEY
UNDER

Application No. 27804 Permit No. 21821
IN NAME OF

George & Francis Braatz

Surveyed Sept. 9, 1958, by *C.D. Barlett*