


T.29S.R.10W.W.M.

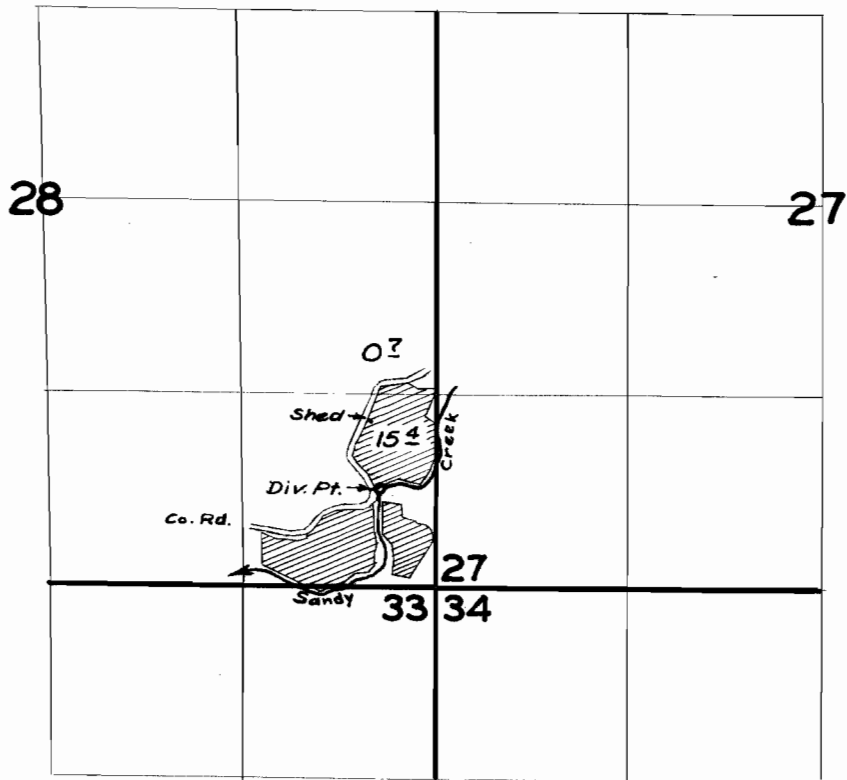

FINAL PROOF SURVEY
UNDER

Application No. 277.55 Permit No. 21853
IN NAME OF

Chas. L. Bowers

Surveyed 13 June 1958, by Vn. Bish