


T. 2 S. R. 3 E. W.M.

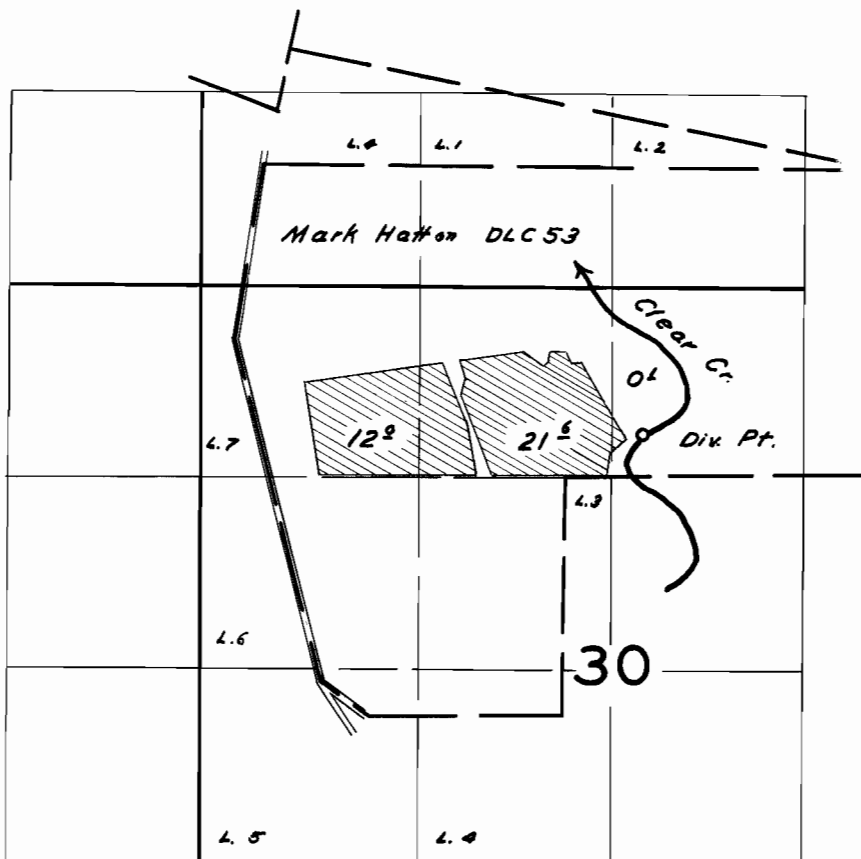

FINAL PROOF SURVEY
UNDER

Application No. 28187 Permit No. 21908
IN NAME OF

Frederick A. & Anna P. Reddaway

Surveyed June 27 1958, by W.N. Perry