


T. 2S. R. 1E. W.M.

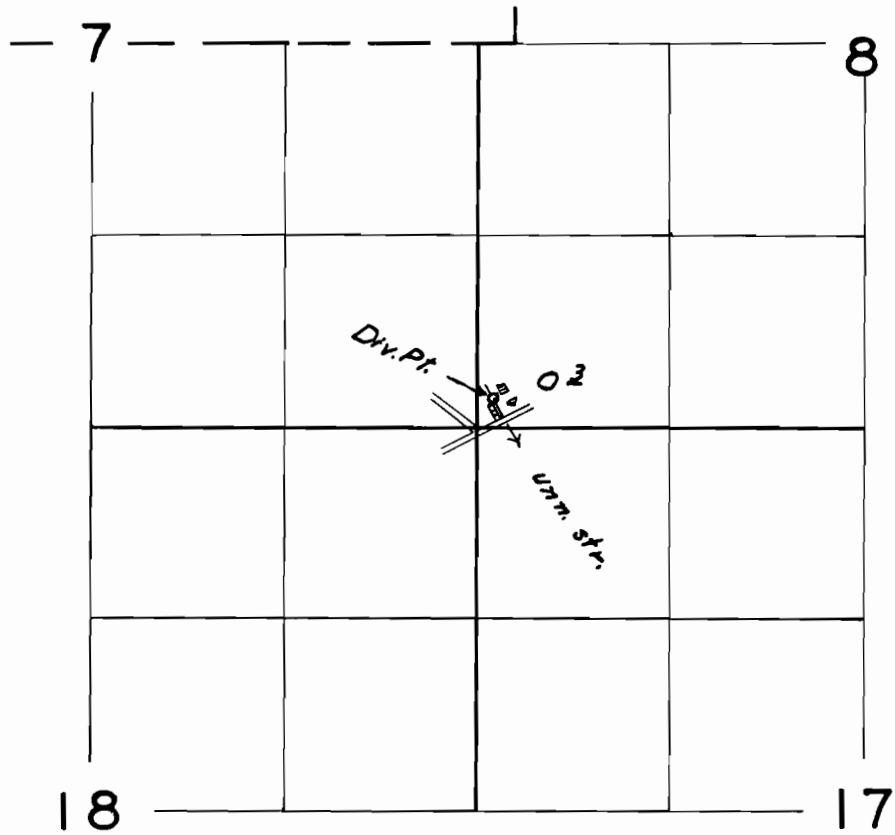

FINAL PROOF SURVEY
UNDER

Application No. *24996* Permit No. *21912*
IN NAME OF

Chester R. Remsen

Surveyed *July 29 1958*, by *W.N. Perry*